

LAND CORNER RECORDATION CERTIFICATE
Filing Requirement of Act 74, Mich. P.A. 1970

For corners in

<u>KALKASKA</u>	Located In:	Corner Code #
(County)		
1998 REMONUMENTATION		
1. Public Land Survey	T. <u>26N</u> R. <u>8W</u>	<u>G-11</u>
	T. _____ R. _____	_____
	T. _____ R. _____	_____
	T. _____ R. _____	_____
2. Property Controlling in Section	S. _____ T. _____ R. _____	_____
	S. _____ T. _____ R. _____	_____
3. Miscellaneous Property in Sec.	S. _____ T. _____ R. _____	_____
	S. _____ T. _____ R. _____	_____

**SURVEY &
REMONUMENTATION**

FEB 22 1999

SECTION

Register of Deeds Stamp & File Number

4. Lot No. _____, Recorded Plat _____

5. Private Claims _____

I, EUGENE FARRIER, in a field survey on November 2, 1998 do hereby state that under requirements of P.A. 74, Michigan P.A. of 1970, the corner points mentioned in lines 1 and 2 above were in conformance with regulations and rules therefore as required in the current manual of survey instructions of the United States Department of the Interior, Bureau of Land Management or by a decree of a Court of Law and/or that the corner points mentioned in lines 3, 4 and 5 above were in conformance with the rules of the Michigan Board of Land Surveyors or by a Decree of a Court of Law; established, re-established, monumented, recovered, found as expressed below:

NOTE: Not more than 2 corners, all in the same town and range, may be recorded on this certificate.

	A	B	C	D	E	F	G	H	I	J	K	L
1												
2	6		5			4		3		2		1
3												
4	7		8			9		10		11		12
5												
6	18		17			16		15		14		13
7												
8	19		20			21		22		23		24
9												
10	30		29			28		27		26		25
11												
12	31		32			33		34		35		36
13												

A. Description of original monument and accessories and/or subsequent restoration:

G-11: Sec. Cor. Common to Secs. 27, 28, 33, & 34, T26N-R8W, Boardman Township
1852, GLO. Sub. resurvey by V.W. Cankin D.S.; set post at corner; Sugar 18", N41°E, 42 Lks. (27.72'); Y. Birch 22", S45°W, 28 Lks. (18.48')
1882, Road Survey by E. Mosher CS. Co. Survey Bk., Pg. 36; found corner
1898, 1900, Sec. Sub. Survey by E.B. Dinnis CS & W.S. Merrill CS., FB # 32, Pg. 82, & FB #19, Pg. 66; shows corner only.
1901, Sec. Sub. Survey by W.S. Merrill CS., Co. Survey Bk. Pg. 4 & 29; fd. iron stake and one Gov't bearing tree.
1902 & 1915, Sec. sub. survey by W.S. Merrill CS., Co. Survey Bk, Pg. 12, 59, & 50; shows corner only.
9-13-74, L. Czubak, fd. 5/8" re-rod Liber 1, Pg. 582, Cert. of Survey
10-30-74, L. Czubak, fd. 5/8" re-rod LCRC, Liber 1, Pg. 329
12-5-85, R. Mitchell, fd. 1/2" re-rod in centerline 4-way road intersection LCRC Liber 2, Pg. 312
10-6-87, E. Farrier, fd. 3/8" iron, Cert. of Survey
11-3-87, E. Farrier, fd. 1/2" re-rod in centerline roads, Cert. of Survey
8-11-91, E. Farrier, fd. 1/2" re-rod in centerline roads, Cert. of Survey
6-15-95, P. Case, fd. 1/2" bar & cap, Liber 4, Pg. 307, Cert. of Survey
12-24-96, E. Farrier, fd. 1/2" re-rod in centerline roads, Cert. of Survey
10-7-97, E. Farrier, fd. 1/2" re-rod in centerline roads, Cert. of Survey

Ratified by Peer Group
P.A. 345 - 1990 Kalkaska County
Chairman Eugene Farrier
Date 2-2-99

B. Description of corner evidence found and/or method applied in restoring or reestablishing corner:


G-11: Sec. Cor. Common to Secs. 27, 28, 33, & 34, T26N-R8W, Boardman Township
Found & accepted 1/2" re-rod in centerline 4-way road intersection (as recorded in LCRC, Liber 1, Pg. 329 & prev. Cert. of Survey)
Pulled & set 5/8" X 18" re-rod & brass cap
N44°W, 66.74'- power pole, fd. nail
S40°E, 44.65'- power pole, fd. nail
No G.L.O. witnesses were found
Kalkaska County Peer Group accepted the above monument as the best available evidence of the position of the original corner.

C. Description of monument for corner and accessories established to perpetuate locating the position of the corner:

G-11: Sec. Cor. Common to Secs. 27, 28, 33, & 34, T26N-R8W, Boardman Township
Found & accepted 1/2" re-rod in centerline 4-way road intersection (as recorded in LCRC, Liber 1, Pg. 329 & prev. Cert. of Survey)
Pulled & set 5/8" X 18" re-rod & brass cap
N72°W, 76.83'- 40" Maple, set nail
N44°W, 66.74'- power pole, fd. nail
S40°E, 44.65'- power pole, fd. nail
S51°W, 52.33', wood guard post (telephone), set nail

Signed by Eugene Farrier
Michigan License No. 24594

Date 2-8-99

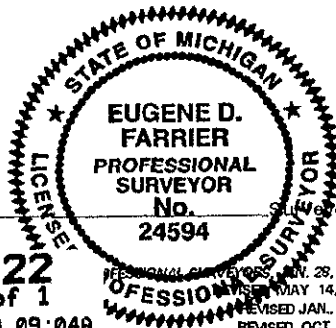

Kalkaska County REMON 9.00 LB: 5 PG: 377

3012722
Page: 1 of 1
02/10/1999 09:04A

PROFESSIONAL SURVEYOR'S ACT, NOV. 28, 1971
REVISED JAN. 1983
REVISED OCT., 199