LAND CORNER RECORDATION CERTIFICATE
Filing Requirement of Act 74, Mich. P.A. 1970

For corners in

KALKASKA (County)

1998 REMONUMENTATION

		Located In:	Corner Code #
1. Public Land Survey		T 26N R 8W	H-9
		T___ R___	
		T___ R___	
		T___ R___	
2. Property Controlling	S___	T___ R___	
in Section	S___	T___ R___	
3. Miscellaneous	S___	T___ R___	
Property in Sec.	S___	T___ R___	

SURVEY & REMONUMENTATION

FEB 22 1999

SECTION

Register of Deeds Stamp & File Number

4. Lot No. _____ , Recorded Plat _____

5. Private Claims _____

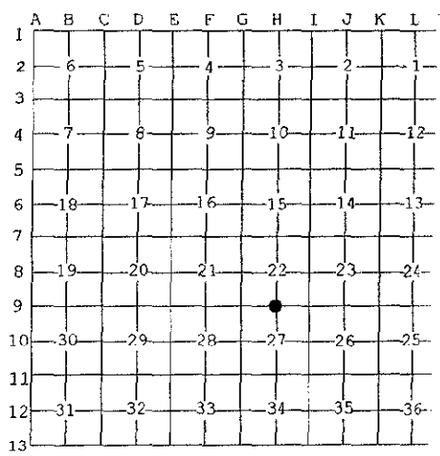

I, EUGENE FARRIER, in a field survey on November 4, 19 98 do hereby state that under requirements of P.A. 74, Michigan P.A. of 1970, the corner points mentioned in lines 1 and 2 above were in conformance with regulations and rules therefore as required in the current manual of survey instructions of the United States Department of the Interior, Bureau of Land Management or by a decree of a Court of Law and /or that the corner points mentioned in lines 3, 4 and 5 above were in conformance with the rules of the Michigan Board of *Land Surveyors or by a Decree of a Court of Law; established, re-established, monumented,* recovered, found as expressed below:

NOTE: Not more than 2 corners, all in the same town and range, may be recorded *on this certificate.*

A. Description of original monument and accessories and/or subsequent restoration:
H-9: 1/4 Cor. Common to Secs. 22 & 27, T26N-R8W, Boardman Township
1852, GLO. Sub. resurvey by V.W. Cankin D.S.; set corner; Hemlock 8", S75°W, 20 Lks. (13.20'); Beech 8", N46°E, 27 Lks. (17.82') swamp C. W-SE, 2.40 Chs. (158.4').
1902, Sec. Sub. Survey by W.S. Merrill CS. Co. Survey Bk., Pg. 12 & 59; found corner; Hemlock stump 24", N12°E, 33 Lks. (21.78'); Hemlock stump 30", East 23 Lks. (15.18').
10-13-74, L. Czubak, set con. mon. from Merrill notes April 19, 1902, Liber 1, Pg. 582
10-30-74, L. Czubak, set con. mon. from Merrill notes April 19, 1902, Cert. of Survey, LCRC Lib. 1, Pg. 329
1-5-78, A. Lennox, fd. con. mon. Lib. 2, Pg. 157, Cert. of Survey

B. Description of corner evidence found and/or method applied in restoring or reestablishing corner:
H-9: 1/4 Cor. Common to Secs. 22 & 27, T26N-R8W, Boardman Township
Fd. & accepted con. mon +/- 4' North of Mature Red Pine Plantation (E-W) (as recorded in LCRC, Liber 1, Pg. 329, and prev. Cert. of Surveys) Added aluminum cap
No G.L.O. witnesses were found.
Kalkaska County Peer Group accepted the above monument as a careful and faithful reestablishment of the position of the original corner

C. Description of monument for corner and accessories established to perpetuate locating the position of the corner:
H-9: 1/4 Cor. Common to Secs. 22 & 27, T26N-R8W, Boardman Township
Fd. & accepted con. mon +/- 4' North of Mature Red Pine Plantation (E-W). Added aluminum cap
N60°E, 86.81' - 36" Twin Maple, set nail & washer
S62°E, 10.27' - 14" R. Pine, set nail & washer
S08°W, 4.24' - 14" R. Pine, set nail & washer
S70°W, 14.82' - 12" R. Pine, set nail & washer

Ratified by Peer Group
P.A. 345 - 1990 Kalkaska County
Chairman Eugene Farrier
Date 2-2-99

STATE OF MICHIGAN
EUGENE D. FARRIER
PROFESSIONAL SURVEYOR
No. 24594
LICENSED PROFESSIONAL SURVEYOR

Signed by Eugene Farrier Date 2-8-99
Michigan License No. 24594

3012727
Page: 1 of 1
02/10/1999 09:07A
Kalkaska County REMON 9.00 LB: 5 PG: 382

SURVEYOR JAN. 28, 19
REVISED MAY 14,19
REVISED JAN., 19
REVISED OCT., 19