

FEB 13 1998

LAND CORNER RECORDATION CERTIFICATE
Filing Requirement of Act 74, Mich. P.A. 1970

SECTION
For corners in

<u>KALKASKA</u>	Located In:	Corner Code #
(County)		
1997 REMONUMENTATION		
1. Public Land Survey	T <u>26N</u> R <u>8W</u>	<u>1-9</u>
	T _____ R _____	_____
	T _____ R _____	_____
	T _____ R _____	_____
2. Property Controlling in Section	S _____ T _____ R _____	_____
	S _____ T _____ R _____	_____
3. Miscellaneous Property in Sec.	S _____ T _____ R _____	_____
	S _____ T _____ R _____	_____

Register of Deeds Stamp & File Number

4. Lot No. _____, Recorded Plat _____

5. Private Claims _____

I, EUGENE FARRIER, in a field survey on OCTOBER 30, 1997 do hereby state that under requirements of P.A. 74, Michigan P.A. of 1970, the corner points mentioned in lines 1 and 2 above were in conformance with regulations and rules therefore as required in the current manual of survey instructions of the United States Department of the Interior, Bureau of Land Management or by a decree of a Court of Law and /or that the corner points mentioned in lines 3, 4 and 5 above were in conformance with the rules of the Michigan Board of Land Surveyors or by a Decree of a Court of Law; established, re-established, monumented, recovered, found as expressed below:

NOTE: Not more than 2 corners, all in the same town and range, may be recorded on this certificate.


A	B	C	D	E	F	G	H	I	J	K	L	M
1												
2	6		5		4		3		2		1	
3												
4	7		8		9		10		11		12	
5												
6	18		17		16		15		14		13	
7												
8	19		20		21		22		23		24	
9												
10	30		29		28		27		26		25	
11												
12	31		32		33		34		35		36	
13												

A. Description of original monument and accessories and/or subsequent restoration:
1-9: Cor. Common to Sec. 22, & 23, 26, & 27 T26N-R8W, Boardman Township
1852, GLO resurvey, set post, 14" Beech S12E, 10, 16" Beech N40W, 30
1903, W.S. Merrill Co. Surveyor, fd. Old stake, set buggy axle, no/accessories
06-27-1974, Perla & Stout survey, set 1" iron pipe by D.P.M., w/accessories, Lib. 1, Pg. 582
08-18-1974, Perla & Stout, LCR, set 1" iron pipe by D.P.M., w/accessories, Lib. 1, Pg. 582
11-23-1977, Lennox & Assoc. Survey, fd. 1" pipe, w/accessories, Lib. 2, Pg. 157
07-06-1989, Farrier Surveying survey, fd. 5/8" iron, w/accessories

B. Description of corner evidence found and/or method applied in restoring or reestablishing corner:
1-9: Cor. Common to Sec. 22, & 23, 26, & 27 T26N-R8W, Boardman Township
Fd. 3/4" iron pipe, 1.5' West C.L. Creighton Rd. & in C.L. Hall Rd. To East. Pulled & replaced with 5/8" x 18" re-bar w/brass cap in mon. box, no GLO witnesses were fd. The Kalkaska Co. Peer group approved & accepted the above monument as a careful and faithful reestablishment of the original corner.

C. Description of monument for corner and accessories established to perpetuate locating the position of the corner:
1-9: Cor. Common to Sec. 22, & 23, 26, & 27 T26N-R8W, Boardman Township
Fd. 3/4" iron pipe, 1.5' West C.L. Creighton Rd. & in C.L. Hall Rd. To East. Pulled & replaced with 5/8" x 18" re-bar w/brass cap in mon. box.
Set nail & tag West, fence post, 33.90'
N45W, gate post, 38.54'
Fd. nail S37E, fence post, 52.16'
Fd. nail S25W, P. Pole, 102.15'

Ratified by Peer Group
P.A. 345 - 1990 Kalkaska County
Chairman Eugene Farrier
Date 1-29-98

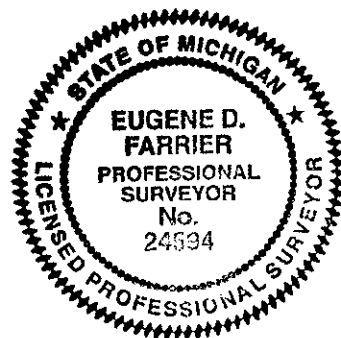

Signed by Eugene Farrier
Surveyor's Michigan License No. 24594

Date 2-3-98



3004846
Page: 1 of 1
02/04/98 11:22A
LB: 5 PG: 250