

SURVEY & REMONUMENTATION

FEB 13 1998

SECTION

LAND CORNER RECORDATION CERTIFICATE
Filing Requirement of Act 74, Mich. P.A. 1970

For corners in

<u>KALKASKA</u>	Located In:	Corner Code #
(County)		
1997 REMONUMENTATION		
1. Public Land Survey	T <u>26N</u> R <u>8W</u>	<u>J-7</u>
	T _____ R _____	_____
	T _____ R _____	_____
	T _____ R _____	_____
2. Property Controlling in Section	S _____ T _____ R _____	_____
	S _____ T _____ R _____	_____
3. Miscellaneous Property in Sec.	S _____ T _____ R _____	_____
	S _____ T _____ R _____	_____

Register of Deeds Stamp & File Number

4. Lot No. _____, Recorded Plat _____

5. Private Claims _____


A	B	C	D	E	F	G	H	I	J	K	L	M
1												
2	6		5		4		3		2		1	
3												
4	7		8		9		10		11		12	
5												
6	18		17		16		15		14		13	
7									●			
8	19		20		21		22		23		24	
9												
10	30		29		28		27		26		25	
11												
12	31		32		33		34		35		36	
13												

I, EUGENE FARRIER, in a field survey on OCTOBER 30, 1997 do hereby state that under requirements of P.A. 74, Michigan P.A. of 1970, the corner points mentioned in lines 1 and 2 above were in conformance with regulations and rules therefore as required in the current manual of survey instructions of the United States Department of the Interior, Bureau of Land Management or by a decree of a Court of Law and for that the corner points mentioned in lines 3, 4 and 5 above were in conformance with the rules of the Michigan Board of Land Surveyors or by a Decree of a Court of Law; established, re-established, monumented, recovered, found as expressed below:

NOTE: Not more than 2 corners, all in the same town and range, may be recorded on this certificate.

A. Description of original monument and accessories and/or subsequent restoration:

- J-7: 1/4 Cor. Common to Sec. 14 & 23, T26N-R8W, Boardman Township
- 1852, GLO resurvey, set post, 8" Beech N32W, 31, 5" Beech S47W, 21
- 05-10-1902, W.S. Merrill Co. Surveyor, iron stake w/accessory
- 09-16 & 17, 1912, W.S. Merrill Co. Surveyor, used cor. No accessories
- 08-20-1975, Granger Eng. Inc., set 1/2" Iron & cap, w/accessories, Lib. 1, Pgs. 779-780
- 08-14-1975, James L. Fletcher #19830, LCR, set 1/2" iron & cap, w/accessories, Lib. 1, Pg. 365
- 04-07-1976, J.L. Wilcox #14102, survey, fd. 1/2" iron & cap, w/accessories, Lib. 1, Pg. 897
- 04-07-1976, J.L. Wilcox #14102, LCR, fd. 1/2" iron & cap, w/accessories, Lib. 1, Pg. 384
- 05-10-1982, Farrier Surveying, survey, w/accessories, Lib. 1, Pg. 365
- 07-06-1989, Farrier Surveying, survey, fd. 5/8" rerod, w/accessories

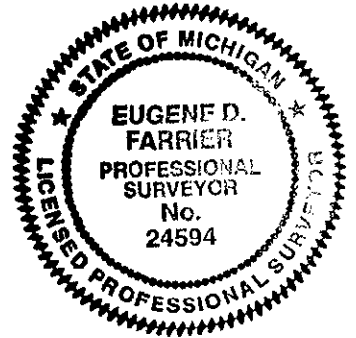

B. Description of corner evidence found and/or method applied in restoring or reestablishing corner:

- J-7: 1/4 Cor. Common to Sec. 14 & 23, T26N-R8W, Boardman Township
- Fd. 1/2" iron & cap. Could not read number on cap. 0.5' South C.L. Boardman Rd. Pulled & replaced with 5/8" x 18" rebar w/brass cap. No GLO witnesses were fd. The Kalkaska Co. Peer group approved & accepted the above monument as the best available evidence of the position of the original corner.

Ratified by Peer Group
P.A. 345 - 1990 Kalkaska County
Chairman Eugene Farrier
Date 1-29-98

C. Description of monument for corner and accessories established to perpetuate locating the position of the corner:

- J-7: 1/4 Cor. Common to Sec. 14 & 23, T26N-R8W, Boardman Township
- Fd. 1/2" iron & cap. Could not read number on cap. 0.5' South C.L. Boardman Rd. Pulled & replaced with 5/8" x 18" rebar w/brass cap.
- Fd. nail N03W, P. Pole, 61.86'
- Set nail & tag S57E, 30" Maple 86.43'
- Set nail & tag S17W, 50" Maple, 49.20'
- Fd. nail S55W, 14" R. Pine, 92.50'

Signed by Eugene Farrier
Surveyor's Michigan License No. 24594

Date 2-3-98



3004852
Page: 1 of 1
02/04/98 11:22F