

**SURVEY &
REMONUMENTATION**

FEB 13 1998

SECTION

**LAND CORNER RECORDATION CERTIFICATE
Filing Requirement of Act 74, Mich. P.A. 1970**

For corners in

<u>KALKASKA</u>	Located In:	Corner Code #
(County)		
1997 REMONUMENTATION		
1. Public Land Survey	T. <u>26N</u> R. <u>8W</u>	<u>K-1</u>
	T. <u>27N</u> R. <u>8W</u>	<u>K-13</u>
	T. _____ R. _____	_____
	T. _____ R. _____	_____
2. Property Controlling	S. _____ T. _____ R. _____	_____
in Section	S. _____ T. _____ R. _____	_____
3. Miscellaneous	S. _____ T. _____ R. _____	_____
Property in Sec.	S. _____ T. _____ R. _____	_____

Register of Deeds Stamp & File Number

4. Lot No. _____, Recorded Plat _____

5. Private Claims _____

	A	B	C	D	E	F	G	H	I	J	K	L	M
1													
2	6		5		4		3		2		1		
3													
4	7		8		9		10		11		12		
5													
6	18		17		16		15		14		13		
7													
8	19		20		21		22		23		24		
9													
10	30		29		28		27		26		25		
11													
12	31		32		33		34		35		36		
13													

I, EUGENE FARRIER, in a field survey on OCTOBER 24, 1997 do hereby state that under requirements of P.A. 74, Michigan P.A. of 1970, the corner points mentioned in lines 1 and 2 above were in conformance with regulations and rules therefore as required in the current manual of survey instructions of the United States Department of the Interior, Bureau of Land Management or by a decree of a Court of Law and for that the corner points mentioned in lines 3, 4 and 5 above were in conformance with the rules of the Michigan Board of Land Surveyors or by a Decree of a Court of Law; established, re-established, monumented, recovered, found as expressed below:


NOTE: Not more than 2 corners, all in the same town and range, may be recorded on this certificate.

A. Description of original monument and accessories and/or subsequent restoration:
K-1: Sec. Cor. common Sec. 1 & 2, T26N-R8W, Boardman Township & Cor. common to Sec.'s 35 & 36, T27N-R8W
 1852, GLO resurvey, set post, 18" Y. Pine S58E, 54, 18" Y. Pine, S70W, 98
 06-13-1902, County Surveyor, used cor. No accessories
 03-20-1907, County Surveyor, used cor., no accessories
 12-13-1974, J.L. Wilcox & Assoc. Inc., Cert. Survey, fd. 7" wood post, w/accessories, Lib. 1, Pg. 650
 12-13-1974, J.L. Wilcox & Assoc. Inc., LCR, fd. Sq. Cedar post w/nail in top, w/accessories, Lib. 1, Pg. 349
 08-08-1984, Farrier Surveying, Certified Survey, (witness Lib. 1, Pg. 650)
 02-07-1994, Farrier Surveying, Certified Survey, fd. 7" wood post, replaced w/1 1/2" iron pipe & cap #24594, w/accessories

B. Description of corner evidence found and/or method applied in restoring or reestablishing corner:
K-1: Sec. Cor. common Sec. 1 & 2, T26N-R8W, Boardman Township & Cor. common to Sec.'s 35 & 36, T27N-R8W
 Fd. 1" iron pipe w/cap #24594. Pulled and replaced with 5/8" x 18" rebar w/aluminum cap. Fd. Y. Pine stump (GLO). The Kalkaska Co. Peer group approved the above monument as careful and faithful perpetuation of the position of the original corner.

Reviewed by Peer Group
 P.A. 345 - 1990 Kalkaska County
 Chairman Eugene Farrier
 Date 1-29-98

C. Description of monument for corner and accessories established to perpetuate locating the position of the corner:
K-1: Sec. Cor. common Sec. 1 & 2, T26N-R8W, Boardman Township & Cor. common to Sec.'s 35 & 36, T27N-R8W
 Fd. 1" iron pipe w/cap #24594. Pulled and replaced with 5/8" x 18" rebar w/aluminum cap.
 Set nail & tag N10E, 16" R. Pine 41.98'
 Fd. Nail & tag #13603 N45E, 24" Y. Pine stump, 17.97' (GLO)
 Set nail & tag N80E, 22" W. Pine 11.09'
 Set nail & tag S45W, 5" Maple 20.62'
 Set nail & tag N58W, 5" Oak, 6.67'

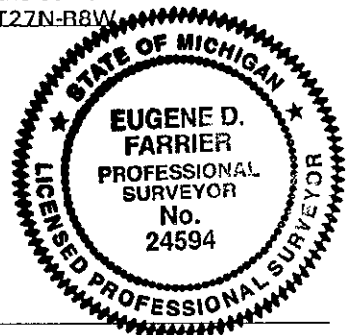

Signed by Eugene Farrier
 Surveyor's Michigan License No. 24594

Date 2-3-98



3004856
 Page: 1 of 1
 02/04/98 11:22F