

**SURVEY & REMONUMENTATION**

**FEB 13 1998**

**SECTION**

**LAND CORNER RECORDATION CERTIFICATE**  
Filing Requirement of Act 74, Mich. P.A. 1970

For corners in

<u>KALKASKA</u>	Located In:	Corner Code #
(County)		
1997 REMONUMENTATION		
1. Public Land Survey	T <u>26N</u> R <u>8W</u>	<u>K-2</u>
	T _____ R _____	_____
	T _____ R _____	_____
	T _____ R _____	_____
2. Property Controlling in Section	S _____ T _____ R _____	_____
	S _____ T _____ R _____	_____
3. Miscellaneous Property in Sec.	S _____ T _____ R _____	_____
	S _____ T _____ R _____	_____

Register of Deeds Stamp & File Number

4. Lot No. \_\_\_\_\_, Recorded Plat \_\_\_\_\_

5. Private Claims \_\_\_\_\_

	A	B	C	D	E	F	G	H	I	J	K	L	M
1													
2	6		5		4		3		2		1		
3													
4	7		8		9		10		11		12		
5													
6	18		17		16		15		14		13		
7													
8	19		20		21		22		23		24		
9													
10	30		29		28		27		26		25		
11													
12	31		32		33		34		35		36		
13													

I, EUGENE FARRIER, in a field survey on OCTOBER 24, 1997 do hereby state that under requirements of P.A. 74, Michigan P.A. of 1970, the corner points mentioned in lines 1 and 2 above were in conformance with regulations and rules therefore as required in the current manual of survey instructions of the United States Department of the Interior, Bureau of Land Management or by a decree of a Court of Law and for that the corner points mentioned in lines 3, 4 and 5 above were in conformance with the rules of the Michigan Board of Land Surveyors or by a Decree of a Court of Law; established, re-established, monumented, recovered, found as expressed below:

NOTE: Not more than 2 corners, all in the same town and range, may be recorded on this certificate.

A. Description of original monument and accessories and/or subsequent restoration:

- K-2: Cor. common Sec. 1 & 2, T26N-R8W, Boardman Township
- 1852, GLO resurvey, set post, 14" W. Pine N30E, 11, 6" Cedar N15W, 16
- 06-13-1902, County Surveyor, used cor. w/accessories
- 11-03-1971, G.F. Dely #5234, Cert. Survey, used cor., no accessories, Lib. 1, Pg. 345
- 06-17-1980, L. Dragoo #3921, Cert. Survey, fd. Iron pipe, no accessories, Lib. 2, Pg. 565
- 11-1981, Farrier Surveying, LCR, fd. 3/4" iron (bent) reset inside 1 1/2" iron pipe, w/accessories, Lib. 2, Pg. 409
- 10-26-1982, L. Dragoo #3921, Cert. Survey, fd. Iron pipe, no accessories, Lib. 2, Pg. 741
- 10-19-1993, Farrier Surveying, LCR, reestablished by finding & prorating to (Merrill) fd. Cent. 1/4, fd. 1" iron pipe @ C/L Pl of Rd. That is W. 698' from the E. 1/4 cor. Sec. 2, setting 1/2" iron rod & cap at cor.; Fd. the 3/4" iron pipe inside 1 1/2" iron pipe. Iron pipe rec. In Lib. #2 Pg. 409 in error, w/accessories, Lib. 3, Pg. 40
- 10-19-1993, Farrier Surveying, Cert. Survey, set 1/2" rerod & cap #24594 at sp. Dist. from fd. Merrills C.P. & 1" iron pipe C/L Pl. Rd. Survey 698' W. Of E. 1/4 cor. Of Sec. 2, T26N-R8W, w/accessories
- 08-07-1995, B.M. Jones #23514, Cert. Survey, fd. 1/2" iron bar, w/accessories, Lib. 4, Pg. 321

B. Description of corner evidence found and/or method applied in restoring or reestablishing corner:

K-2: Cor. common Sec. 1 & 2, T26N-R8W, Boardman Township  
Fd. 1/2" iron & cap #24594, 51' Southeast of CL Hwy. US131. Pulled and replaced with 5/8" x 18" rebar, w/aluminum cap. No GLO witnesses were fd. The Kalkaska Co. Peer group approved & accepted the above monument as a careful and faithful reestablishment of the position of the original corner.


C. Description of monument for corner and accessories established to perpetuate locating the position of the corner:

K-2: Cor. common Sec. 1 & 2, T26N-R8W, Boardman Township  
Fd. 1/2" iron & cap #24594, 51' Southeast of CL Hwy. US131. Pulled and replaced with 5/8" x 18" rebar, w/aluminum cap.  
Fd. Nail S42W 9" Poplar, 88.88'  
S40W, top conc. R/W marker, 94.64'  
S82E, top conc. R/W marker, 11.89'  
S77W, 3/4" iron pipe, 45.37'  
S43E fd. Spike CL RR tracks, 74.79'

Ratified by Peer Group  
P.A. 345 - 1990 Kalkaska County  
Chairman Eugene Farrier  
Date 1-29-98

Signed by Eugene Farrier  
Surveyor's Michigan License No. 24594

Date 2-3-98

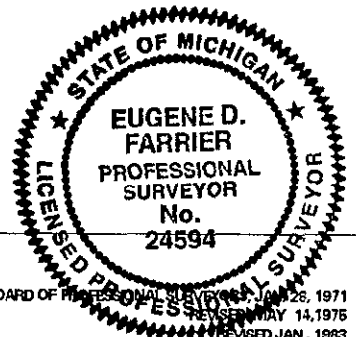

3004857  
Page: 1 of 1  
02/04/98 11:22f