

**SURVEY & REMONUMENTATION**

**FEB 13 1998**

**SECTION**

**LAND CORNER RECORDATION CERTIFICATE**  
**Filing Requirement of Act 74, Mich. P.A. 1970**

For corners in

<u>KALKASKA</u>	Located In:	Corner Code #
(County)		
1997 REMONUMENTATION		
1. Public Land Survey	T. <u>26N</u> R. <u>8W</u>	<u>K-4</u>
	T. _____ R. _____	_____
	T. _____ R. _____	_____
	T. _____ R. _____	_____
2. Property Controlling in Section	S. _____ T. _____ R. _____	_____
	S. _____ T. _____ R. _____	_____
3. Miscellaneous Property in Sec.	S. _____ T. _____ R. _____	_____
	S. _____ T. _____ R. _____	_____

Register of Deeds Stamp & File Number

4. Lot No. \_\_\_\_\_, Recorded Plat \_\_\_\_\_

5. Private Claims \_\_\_\_\_

A	B	C	D	E	F	G	H	I	J	K	L	M
1												
2	6	5	4	3	2	1						
3												
4	7	8	9	10	11	12						
5												
6	18	17	16	15	14	13						
7												
8	19	20	21	22	23	24						
9												
10	30	29	28	27	26	25						
11												
12	31	32	33	34	35	36						
13												

I, EUGENE FARRIER, in a field survey on OCTOBER 31, 1997 do hereby state that under requirements of P.A. 74, Michigan P.A. of 1970, the corner points mentioned in lines 1 and 2 above were in conformance with regulations and rules therefore as required in the current manual of survey instructions of the United States Department of the Interior, Bureau of Land Management or by a decree of a Court of Law and for that the corner points mentioned in lines 3, 4 and 5 above were in conformance with the rules of the Michigan Board of Land Surveyors or by a Decree of a Court of Law; established, re-established, monumented, recovered, found as expressed below:


**NOTE: Not more than 2 corners, all in the same town and range, may be recorded on this certificate.**

A. Description of original monument and accessories and/or subsequent restoration:  
**K-4: 1/4 Cor. Common to Sec. 11 & 12, T26N-R8W, Boardman Township**  
 1852, GLO resurvey, set cor., 14" Sugar, N22E 24, 7" Sugar, S42W 27  
 06-21-1973, Perla & Stout P.C., Cert. Survey, fd. Iron w/accessories, Lib. 1, Pg. 327  
 May 1974, J.L. Wilcox #14102, LCR, fd. Iron & cap #5942 w/accessories, Lib. 1, Pg. 336  
 07-30-1975, J.L. Wilcox & Assoc., Cert. Survey, fd. 1/2" iron & cap w/accessories  
 July 1975, J.L. Wilcox #14102, LCR fd. Iron rod w/accessories, Lib. 1, Pg. 356

B. Description of corner evidence found and/or method applied in restoring or reestablishing corner:  
**K-4: 1/4 Cor. Common to Sec. 11 & 12, T26N-R8W, Boardman Township**  
 Fd. 5/8" iron & cap #5942 in C/L Crofton Rd. & on old fence line to East. Set brass cap in mon box. No GLO witnesses were fd. The Kalkaska Co. Peer group approved the above monument and is accepted as the best available evidence of the position of the original corner.

C. Description of monument for corner and accessories established to perpetuate locating the position of the corner:  
**K-4: 1/4 Cor. Common to Sec. 11 & 12, T26N-R8W, Boardman Township**  
 Fd. 5/8" iron & cap #5942 in C/L Crofton Rd. & on old fence line to East. Set brass cap in mon box.  
 Set nail & tag N45E, 4" Cedar 55.59'  
 Fd. Nail S70E, fence post 46.80'  
 Set nail & tag S40E, fence post 69.43'  
 Fd. West, iron & cap #14102, 33.01'

Ratified by Peer Group  
**P.A. 345 - 1990 Kalkaska County**  
 Chairman Eugene Farrier  
 Date 1-29-98

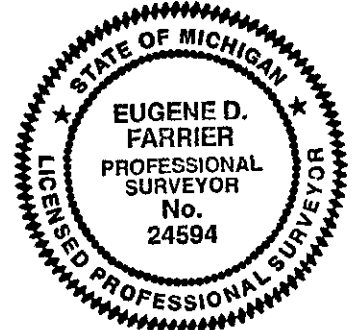

Signed by Eugene Farrier  
 Surveyor's Michigan License No. 24594

Date 2-3-98



**3004859**  
 Page: 1 of 1  
 02/04/98 11:22f  
 LB: 5 PG: 263