

SURVEY & REMONUMENTATION

FEB 13 1998

SECTION

LAND CORNER RECORDATION CERTIFICATE Filing Requirement of Act 74, Mich. P.A. 1970

For corners in

KALKASKA Located In: Corner Code #
(County)
1997 REMONUMENTATION
1. Public Land Survey T 26N R 8W K-5
T R
T R
T R
2. Property Controlling S T R
in Section S T R
3. Miscellaneous S T R
Property in Sec. S T R

Register of Deeds Stamp & File Number


4. Lot No. _____, Recorded Plat _____
5. Private Claims _____

	A	B	C	D	E	F	G	H	I	J	K	L	M
1													
2		6		5		4		3		2		1	
3													
4		7		8		9		10		11		12	
5													
6		18		17		16		15		14		13	
7													
8		19		20		21		22		23		24	
9													
10		30		29		28		27		26		25	
11													
12		31		32		33		34		35		36	
13													

I, EUGENE FARRIER, in a field survey on OCTOBER 31, 1997 do hereby state that under requirements of P.A. 74, Michigan P.A. of 1970, the corner points mentioned in lines 1 and 2 above were in conformance with regulations and rules therefore as required in the current manual of survey instructions of the United States Department of the Interior, Bureau of Land Management or by a decree of a Court of Law and /or that the corner points mentioned in lines 3, 4 and 5 above were in conformance with the rules of the Michigan Board of Land Surveyors or by a Decree of a Court of Law; established, re-established, monumented, recovered, found as expressed below:

NOTE: Not more than 2 corners, all in the same town and range, may be recorded on this certificate.

- A. Description of original monument and accessories and/or subsequent restoration:
 K-5: Cor. common Sec. 11, 12, 13 & 14, T26N-R8W, Boardman Township
 1852, GLO resurvey, set post, 14" Sugar S78E, 24, 14" Sugar S40W, 11
 05-10-1902, County Surveyor, used corn. No accessories
 06-21-1973, Perla & Stout P.C., Cert. Survey, set 1/2" iron & cap #5942, w/accessories, Lib. 1, 327
 05-1974, J.L. Wilcox & Assoc. Inc., LCR, fd. 1/2" iron & cap 5942, w/accessories, Lib. 1, 336
 11-07-1974, Granger Eng. Inc., Cert. Survey, fd. Iron, w/accessories, Lib. 1, Pg. 632
 07-30-1975, J.L. Wilcox & Assoc. Inc., Certified Survey, fd. 1/2" iron & cap, w/accessories
 07-1975, J.L. Wilcox & Assoc. Inc., LCR, fd. 1/2" iron & cap, w/accessories, Lib. 1, Pg. 355
 10-30-1975, J.L. Wilcox & Assoc. Inc., Certified Survey, fd. 1/2" iron & cap, w/accessories, Lib. 1, Pg. 891
 03-13-1981, W.B. Batzer #13026, Cert. Survey, fd. Iron & cap, w/accessories, Lib 2, Pg. 641
 12-14-1982, Farrier Surveying, Cert. Survey, (witnessed Lib. 1, Pg. 336)

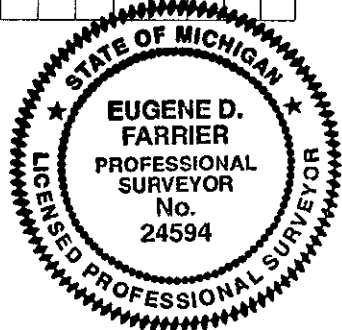

B. Description of corner evidence found and/or method applied in restoring or reestablishing corner:
 K-5: Cor. common Sec. 11, 12, 13 & 14, T26N-R8W, Boardman Township
 Fd. 5/8" iron & cap #5942, 2.5' West & 3' North of C.L. Inter. Crofton Rd. & Bass Lake Rd., set brass cap in mon. box. No GLO witnesses were fd. The Kalkaska Co. Peer group approved & accepted the above monument as the best available evidence of the position of the original corner.

C. Description of monument for corner and accessories established to perpetuate locating the position of the corner:
 K-5: Cor. common Sec. 11, 12, 13 & 14, T26N-R8W, Boardman Township
 Fd. 5/8" iron & cap #5942, 2.5' West & 3' North of C.L. Inter. Crofton Rd. & Bass Lake Rd., set brass cap in mon. box.
 Fd. Nail N35E, 16" Maple 57.31'
 Fd. Nail N66E, 20" Maple 54.39'
 Fd. Nail S42W, 8" R. Pine 66.85'
 S63W, stop sign post 34.80'

Ratified by Peer Group
 P.A. 345 - 1990 Kalkaska County
 Chairman Eugene Farrier
 Date 1-29-98

Signed by Eugene Farrier Date 2-3-98
 Surveyor's Michigan License No. 24594