

FEB 13 1998

SECTION

LAND CORNER RECORDATION CERTIFICATE
Filing Requirement of Act 74, Mich. P.A. 1970

For corners in

<u>KALKASKA</u>	Located In:	Corner Code #
(County)		
1997 REMONUMENTATION		
1. Public Land Survey	T <u>26N</u> R <u>8W</u>	<u>K-6</u>
	T _____ R _____	_____
	T _____ R _____	_____
	T _____ R _____	_____
2. Property Controlling in Section	S _____ T _____ R _____	_____
	S _____ T _____ R _____	_____
3. Miscellaneous Property in Sec.	S _____ T _____ R _____	_____
	S _____ T _____ R _____	_____

Register of Deeds Stamp & File Number

4. Lot No. _____, Recorded Plat _____

5. Private Claims _____

I, EUGENE FARRIER, in a field survey on OCTOBER 30, 1997 do hereby state that under requirements of P.A. 74, Michigan P.A. of 1970, the corner points mentioned in lines 1 and 2 above were in conformance with regulations and rules therefore as required in the current manual of survey instructions of the United States Department of the Interior, Bureau of Land Management or by a decree of a Court of Law and /or that the corner points mentioned in lines 3, 4 and 5 above were in conformance with the rules of the Michigan Board of Land Surveyors or by a Decree of a Court of Law; established, re-established, monumented, recovered, found as expressed below:

NOTE: Not more than 2 corners, all in the same town and range, may be recorded on this certificate.


A	B	C	D	E	F	G	H	I	J	K	L	M
1												
2	6		5		4		3		2		1	
3												
4	7		8		9		10		11		12	
5												
6	18		17		16		15		14	●	13	
7												
8	19		20		21		22		23		24	
9												
10	30		29		28		27		26		25	
11												
12	31		32		33		34		35		36	
13												

A. Description of original monument and accessories and/or subsequent restoration:
K-6: Cor. common Sec. 13 & 14, T26N-R8W, Boardman Township
 1852, GLO resurvey, set post, 8" Beech N55E, 22, 12" Beech S2W, 18
 05-10-1902, County Surveyor, used cor. No accessories
 07-1975, J.L. Wilcox & Assoc. Inc., LCR, set 1/2" iron S.P.M., w/accessories, Lib. 1, Pg. 355
 07-03-1975, J.L. Wilcox & Assoc. Inc., Cert. Survey, set 1/2" iron S.P.M. w/accessories, Lib. 1, Pg. 154
 08-14-1975, Granger Eng. Inc., LCR, fd 1/2" rod w/accessories, Lib. 1, Pg. 365
 08-20-1975, Granger Eng. Inc., Cert. Survey, used cor., w/accessories, Lib. 1, Pg. 780
 05-10-1982, Farrier Surveying, Cert. Survey, (rec. Lib. 1, Pg. 365)
 12-14-1982, Farrier Surveying, Cert. Survey, (rec. Lib. 1, Pg. 355)

B. Description of corner evidence found and/or method applied in restoring or reestablishing corner:
K-6: Cor. common Sec. 13 & 14, T26N-R8W, Boardman Township
 Fd. 1/2" rebar 5' West of C.L. Crofton Rd. Pulled and replaced with 5/8" x 18" rebar w/brass cap in mon. box. No GLO witnesses were fd. The Kalkaska Co. Peer group approved the above monument as careful and faithful reestablishment of the position of the original corner.

C. Description of monument for corner and accessories established to perpetuate locating the position of the corner:
K-6: Cor. common Sec. 13 & 14, T26N-R8W, Boardman Township
 Fd. 1/2" rebar 5' West of C.L. Crofton Rd. Pulled and replaced with 5/8" x 18" rebar w/brass cap in mon. box.
 Fd. Nail S85E wood riser post (fiber optics) 53.42'
 Set nail & tag S22E, 7" Spruce 79.51'
 Fd. Nail S66W, 12" Tw. Cedar 77.10'
 Fd. Nail N85W, wood riser post (fiber optics) 29.51'

Ratified by Peer Group
P.A. 345 - 1990 Kalkaska County
 Chairman Eugene Farrier
 Date 1-29-98

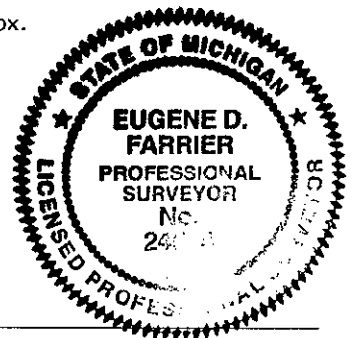

Signed by Eugene Farrier
 Surveyor's Michigan License No. 24594

Date 2-3-98



3004861
 Page: 1 of 1
 02/04/98 11:22f