

SURVEY & REMONUMENTATION

FEB 13 1998

SECTION

LAND CORNER RECORDATION CERTIFICATE Filing Requirement of Act 74, Mich. P.A. 1970

For corners in

<u>KALKASKA</u>	Located In:	Corner Code #
(County)		
1997 REMONUMENTATION		
1. Public Land Survey	T <u>26N</u> R <u>8W</u>	<u>K-7</u>
	T _____ R _____	_____
	T _____ R _____	_____
	T _____ R _____	_____
2. Property Controlling in Section	S _____ T _____ R _____	_____
	S _____ T _____ R _____	_____
3. Miscellaneous Property in Sec.	S _____ T _____ R _____	_____
	S _____ T _____ R _____	_____

Register of Deeds Stamp & File Number

4. Lot No. _____, Recorded Plat _____

5. Private Claims _____


I, EUGENE FARRIER, in a field survey on NOVEMBER 21, 1997 do hereby state that under requirements of P.A. 74, Michigan P.A. of 1970, the corner points mentioned in lines 1 and 2 above were in conformance with regulations and rules therefore as required in the current manual of survey instructions of the United States Department of the Interior, Bureau of Land Management or by a decree of a Court of Law and /or that the corner points mentioned in lines 3, 4 and 5 above were in conformance with the rules of the Michigan Board of Land Surveyors or by a Decree of a Court of Law; established, re-established, monumented, recovered, found as expressed below:

NOTE: Not more than 2 corners, all in the same town and range, may be recorded on this certificate.

	A	B	C	D	E	F	G	H	I	J	K	L	M
1													
2	6		5		4		3		2		1		
3													
4	7		8		9		10		11		12		
5													
6	18		17		16		15		14		13		
7													
8	19		20		21		22		23		24		
9													
10	30		29		28		27		26		25		
11													
12	31		32		33		34		35		36		
13													

A. Description of original monument and accessories and/or subsequent restoration:

- K-7: Cor. Common to Sec. 13, 14, 23 & 24, T26N-R8W, Boardman Township
- 1852, GLO resurvey, set POST, 20" Sugar S12W, 29, 12" Beech S17E, 62
- 04-30-1901, Co. Surveyor, used cor., no accessories
- 04-19-1903, W.S. Merrill Co. Surveyor, Cedar stake set witness stone 2' long S40E, 70 links
- 09-16-1912, Co. Surveyor, used cor., w/accessories
- 07-14-1975, J.L. Wilcox & Assoc., Cert. Survey, fd. 3/4" Pipe, w/accessories Lib. 1, Pg. 688
- 07-14-1975, J.L. Wilcox & Assoc., LCR, fd. 3/4" Pipe, w/accessories Lib. 1, Pg. 355
- 08-14-1975, Granger Engineering, LCR, fd. 1" iron pipe in mon. box, w/accessories
- 08-20-1975, Granger Engineering, Cert. Survey, used cor. w/accessories
- 12-16-1977, J.L. Wilcox & Assoc., Cert. Survey, fd. 3/4" pipe, w/accessories Lib. 2, Pg. 154
- 05-10-1982, Farrier Surveying, Cert. Survey, used cor., accessories in Lib. 1, Pg. 365
- 07-06-1989, Farrier Surveying, Cert. Survey, Fd. 3/4" iron in mon. box, w/accessories
- 09-14-1989, Farrier Surveying, Cert. Survey, Fd. 3/4" iron in mon. box, w/accessories
- 04-13-1990, Farrier Surveying, Cert. Survey, Fd. 3/4" iron in mon. box, w/accessories
- 04-13-1990, Farrier Surveying, LCR, Fd. 3/4" iron in mon. box, w/accessories
- 07-19-1996, Farrier Surveying, Cert. Survey, Fd. 3/4" iron in mon. box, w/accessories

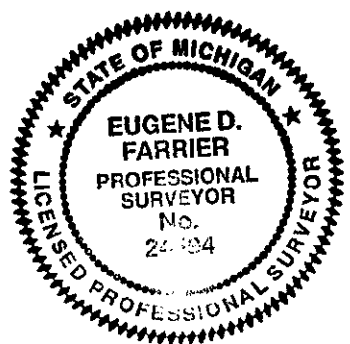

B. Description of corner evidence found and/or method applied in restoring or reestablishing corner:

K-7: Cor. Common to Sec. 13, 14, 23 & 24, T26N-R8W, Boardman Township
Fd. 3/4" x 6" iron pipe over large stone in mon. box, 1' South & 8' West of CL Boardman Rd. & Hart Rd., pulled and replaced with 5/8" x 6" rebar w/brass cap. No GLO witnesses were fd. The Kalkaska Co. Peer group approved and accepted the above monument as the best available evidence of the position of the original corner.

C. Description of monument for corner and accessories established to perpetuate locating the position of the corner:

K-7: Cor. Common to Sec. 13, 14, 23 & 24, T26N-R8W, Boardman Township
Fd. 3/4" x 6" iron pipe over large stone in mon. box, 1' South & 8' West of CL Boardman Rd. & Hart Rd., pulled and replaced with 5/8" x 6" rebar w/brass cap.
Fd. Nail S28°E 30" Maple 75.06'
Fd. PK S25°W W. End 15" CMP 75.15'
Fd. Nail N20°E 8" Locust 70.67'
Fd. Nail N72°E P. Pole 75.36'

Ratified by Peer Group
P.A. 345 - 1990 Kalkaska County
Chairman Eugene Farrier
Date 1-29-98

Signed by Eugene Farrier
Surveyor's Michigan License No. 24594

Date 2-3-98



3004852
Page: 1 of 1
02/04/98 11:22f