

SURVEY & REMONUMENTATION

FEB 13 1998

SECTION

**LAND CORNER RECORDATION CERTIFICATE
Filing Requirement of Act 74, Mich. P.A. 1970**

For corners in

<u>KALKASKA</u>	Located In:	Corner Code #
(County)		
1997 REMONUMENTATION		
1. Public Land Survey	<u>T 26N R 8W</u>	<u>K-8</u>
	T <u> </u> R <u> </u>	<u> </u>
	T <u> </u> R <u> </u>	<u> </u>
	T <u> </u> R <u> </u>	<u> </u>
2. Property Controlling in Section	S <u> </u> T <u> </u> R <u> </u>	<u> </u>
	S <u> </u> T <u> </u> R <u> </u>	<u> </u>
3. Miscellaneous Property in Sec.	S <u> </u> T <u> </u> R <u> </u>	<u> </u>
	S <u> </u> T <u> </u> R <u> </u>	<u> </u>

Register of Deeds Stamp & File Number

4. Lot No. _____, Recorded Plat _____

5. Private Claims _____

I, EUGENE FARRIER, in a field survey on OCTOBER 30, 1997 do hereby state that under requirements of P.A. 74, Michigan P.A. of 1970, the corner points mentioned in lines 1 and 2 above were in conformance with regulations and rules therefore as required in the current manual of survey instructions of the United States Department of the Interior, Bureau of Land Management or by a decree of a Court of Law and /or that the corner points mentioned in lines 3, 4 and 5 above were in conformance with the rules of the Michigan Board of Land Surveyors or by a Decree of a Court of Law; established, re-established, monumented, recovered, found as expressed below:

A	B	C	D	E	F	G	H	I	J	K	L	M
1												
2	6		5		4		3		2		1	
3												
4	7		8		9		10		11		12	
5												
6	18		17		16		15		14		13	
7												
8	19		20		21		22		23	●	24	
9												
10	30		29		28		27		26		25	
11												
12	31		32		33		34		35		36	
13												


NOTE: Not more than 2 corners, all in the same town and range, may be recorded on this certificate.

A. Description of original monument and accessories and/or subsequent restoration:
K-8: Cor. common Sec. 23 & 24, T26N-R8W, Boardman Township
 1852, GLO resurvey, set post, 14" Hemlock S50E, 17, 10" Hemlock S75W, 12
 04-30-1901, W.S. Merrill Co. Surveyor, used cor., no accessories
 09-17-1912, County Surveyor, used cor., no accessories
 08-30-1985, Farrier Surveying, Cert. Survey, fd. 1" x 24" iron pin & wood stake over stone
 07-06-1989, Farrier Surveying, Cert. Survey, fd. 1" x 24" iron pin & wood stake over stone
 09-14-1989, Farrier Surveying, Cert. Survey, fd. 1" x 24" iron pin & wood stake over stone w/accessories
 10-1989, Farrier Surveying, LCR, fd. 1" X 24" iron pin & wood stake over stone w/accessories
 10-21-1996, Farrier Surveying, Cert. Survey, fd. 1" x 24" iron pin & wood stake over stone w/accessories

B. Description of corner evidence found and/or method applied in restoring or reestablishing corner:
K-8: Cor. common Sec. 23 & 24, T26N-R8W, Boardman Township
 Fd. 1/2" iron & cap 24594 raised over 1" x 24" iron pin & wood stake over stone 2' East C.L. Hart Rd., on fence line to East. Pulled and replaced with 5/8" x 18" rebar w/brass cap in mon. box. No GLO witnesses were fd. The Kalkaska Co. Peer group approved & accepted the above monument as the best available evidence of the position of the original corner.

C. Description of monument for corner and accessories established to perpetuate locating the position of the corner:
K-8: Cor. common Sec. 23 & 24, T26N-R8W, Boardman Township
 Fd. 1/2" iron & cap 24594 raised over 1" x 24" iron pin & wood stake over stone 2' East C.L. Hart Rd., on fence line to East. Pulled and replaced with 5/8" x 18" rebar w/brass cap in mon. box.
 Fd. West 1/2" iron & cap 12581 6.65'
 Fd. Spike N46E, 10" R. Pine 64.58'
 Set Nail & tag N35W, 6" Ash 46.27'
 Fd. Spike S33E fence post 62.67'

Ratified by Peer Group
P.A. 345 - 1990 Kalkaska County
 Chairman Eugene Farrier
 Date 1-29-98

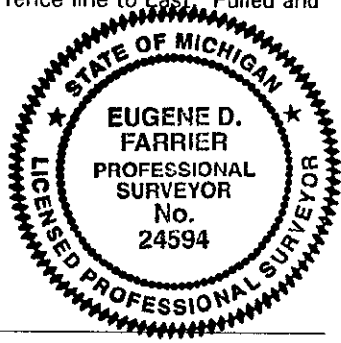

Signed by Eugene Farrier Date 2-3-98
 Surveyor's Michigan License No. 24594