

SURVEY & REMONUMENTATION

FEB 13 1998

SECTION

LAND CORNER RECORDATION CERTIFICATE
Filing Requirement of Act 74, Mich. P.A. 1970

For corners in

<u>KALKASKA</u>	Located In:	Corner Code #
(County)		
1997 REMONUMENTATION		
1. Public Land Survey	T <u>26N</u> R <u>8W</u>	<u>K-10</u>
	T _____ R _____	_____
	T _____ R _____	_____
	T _____ R _____	_____
2. Property Controlling in Section	S _____ T _____ R _____	_____
	S _____ T _____ R _____	_____
3. Miscellaneous Property in Sec.	S _____ T _____ R _____	_____
	S _____ T _____ R _____	_____

Register of Deeds Stamp & File Number

4. Lot No. _____, Recorded Plat _____

5. Private Claims _____

A	B	C	D	E	F	G	H	I	J	K	L	M
1												
2	6		5		4		3		2		1	
3												
4	7		8		9		10		11		12	
5												
6	18		17		16		15		14		13	
7												
8	19		20		21		22		23		24	
9												
10	30		29		28		27		26	●	25	
11												
12	31		32		33		34		35		36	
13												

I, EUGENE FARRIER, in a field survey on OCTOBER 23, 1997 do hereby state that under requirements of P.A. 74, Michigan P.A. of 1970, the corner points mentioned in lines 1 and 2 above were in conformance with regulations and rules therefore as required in the current manual of survey instructions of the United States Department of the Interior, Bureau of Land Management or by a decree of a Court of Law and for that the corner points mentioned in lines 3, 4 and 5 above were in conformance with the rules of the Michigan Board of Land Surveyors or by a Decree of a Court of Law; established, re-established, monumented, recovered, found as expressed below:


NOTE: Not more than 2 corners, all in the same town and range, may be recorded on this certificate.

A. Description of original monument and accessories and/or subsequent restoration:
K-10: 1/4 Cor. Common to Sec. 25 & 26, T26N-R8W, Boardman Township
1852, GLO resurvey, set cor. 14" Beech, N65W, 5, 10" Beech S35E, 16
04-27-1901, W.S. Merrill, Co. Surveyor, located from GLO bearing trees
04-19-1903, W.S. Merrill, Co. Surveyor, 12" Hemlock N81 1/2W, 14 1/2, 48" pine stump S67W, 30
11-17-1981, N.B. DeYoung #20705, Cert. Survey, fd. 1 1/4" solid rod, w/accessories
04-28-1987, Farrier Surveying, LCR, fd. 3/4" bolt w/1 1/4" hex head, w/accessories, Lib. 2, Pg. 323
05-30-1987, Farrier Surveying, Cert. Survey, Fd. 3/4" bolt w/1 1/4" hex head, w/accessories
06-20-1988, Farrier Surveying, Cert. Survey, Fd. 3/4" bolt w/1 1/4" hex head, w/accessories, Lib. 3, Pg. 234
04-19-1995, Farrier Surveying, Cert. Survey, Fd. 3/4" bolt w/1 1/4" hex head, w/accessories

B. Description of corner evidence found and/or method applied in restoring or reestablishing corner:
K-10: 1/4 Cor. Common to Sec. 25 & 26, T26N-R8W, Boardman Township
Fd. 3/4" round x 36" iron pin w/1" hex head. Pulled and replaced with 5/8" x 18" rebar, w/brass cap, 11' West of CL Hart Rd. No GLO witnesses were fd. The Kalkaska Co. Peer group approved & accepted the above monument as the best available evidence of the position of the original corner.

C. Description of monument for corner and accessories established to perpetuate locating the position of the corner:
K-10: 1/4 Cor. Common to Sec. 25 & 26, T26N-R8W, Boardman Township
Fd. 3/4" round x 36" iron pin w/1" hex head. Pulled and replaced with 5/8" x 18" rebar, w/brass cap, 11' West of CL Hart Rd.
Set nail & tag S85W, 10" W. Pine, 60.40'
Fd. Spike N30W, P. Pole, 46.93'
Set nail & tag S70E, 12" Tw. Maple, 97.69'
Set nail & tag S37E, 4" R. Pine, 84.19'

Ratified by Peer Group
P.A. 345 - 1990 Kalkaska County
Chairman Eugene Farrier
Date 1-29-98

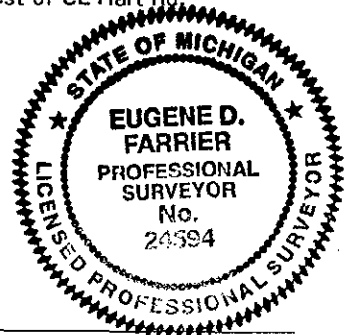

Signed by Eugene Farrier
Surveyor's Michigan License No. 24594

Date 2-3-98



3004865
Page: 1 of 1
02/04/98 11:22f
Kalkaska County REMON