

SURVEY & REMONUMENTATION

FEB 13 1998

LAND CORNER RECORDATION CERTIFICATE Filing Requirement of Act 74, Mich. P.A. 1970

SECTION
For corners in

KALKASKA Located in: Corner Code #
(County)
1997 REMONUMENTATION
1. Public Land Survey T 26N R 8W K-12
T R
T R
T R
2. Property Controlling S T R
in Section S T R
3. Miscellaneous S T R
Property in Sec. S T R

Register of Deeds Stamp & File Number

4. Lot No. _____, Recorded Plat _____

5. Private Claims _____

I, EUGENE FARRIER, in a field survey on SEPTEMBER 30, 1997 do hereby state that under requirements of P.A. 74, Michigan P.A. of 1970, the corner points mentioned in lines 1 and 2 above were in conformance with regulations and rules therefore as required in the current manual of survey instructions of the United States Department of the Interior, Bureau of Land Management or by a decree of a Court of Law and for that the corner points mentioned in lines 3, 4 and 5 above were in conformance with the rules of the Michigan Board of Land Surveyors or by a Decree of a Court of Law; established, re-established, monumented, recovered, found as expressed below:

	A	B	C	D	E	F	G	H	I	J	K	L	M
1													
2	6	5	4	3	2	1							
3													
4	7	8	9	10	11	12							
5													
6	10	17	16	15	14	13							
7													
8	19	20	21	22	23	24							
9													
10	30	29	28	27	26	25							
11													
12	31	32	33	34	35	36							
13													


NOTE: Not more than 2 corners, all in the same town and range, may be recorded on this certificate.

A. Description of original monument and accessories and/or subsequent restoration:
K-12: Cor. Common to Sec. 35 & 36, T26N-R8W, Boardman Township
1852, GLO resurvey, set post, 20" Lynn S45E, 31, 14" Sugar N62W, 9
11-01-1980, Farrier Surveying, L.C.R., Lib. 2 Pg. 293, fd. 1/2" iron w/accessories
08-18-1989, Farrier Surveying, survey, Lib. 3, Pg. 308, fd. 1/2" iron w/accessories
09-08-1992, Neil Way #28432, survey, fd. 1/2" iron w/accessories
11-04-1992, Farrier Surveying, survey, fd. 1/2" iron w/ accessories
05-24-1993, Farrier Surveying, survey, fd. 1/2" iron w/ accessories

B. Description of corner evidence found and/or method applied in restoring or reestablishing corner:
K-12: Cor. Common to Sec. 35 & 36, T26N-R8W, Boardman Township
Fd. 1/2" x 18" iron & cap, pulled & replaced with 5/8" x 18" re-rod w/brass cap 9' West of C.L. Hart Rd. & 28' N. Of Luce Rd. No GLO witnesses were fd. The Kalkaska Co. Peer group approved & accepted the above monument as the best available evidence of the position of the original corner.

C. Description of monument for corner and accessories established to perpetuate locating the position of the corner:
K-12: Cor. Common to Sec. 35 & 36, T26N-R8W, Boardman Township
Fd. 1/2" x 18" iron & cap. Pulled & replaced with 5/8" x 18" re-rod w/brass cap 9' West of C.L. Hart Rd. & 28' N. Of Luce Rd.
Fd. Nail S25E 14" Ash 56.76'
Fd. Nail S35W 12" Maple 6.80'
Fd. Nail N55W 7" Maple 7.27'
Fd. nail N75E 15" Maple 39.60'

Ratified by Peer Group
P.A. 345 - 1990 Kalkaska County
Chairman Eugene Farrier
Date 1-29-98

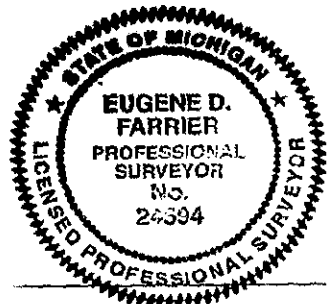

Signed by Eugene Farrier
Surveyor's Michigan License No. 24594

Date 2-3-98



3004867
Page: 1 of 1
02/04/98 11:22
Kalkaska County REMON 8.00 LB: 5 PG: 271

FORM APPROVED BY MICHIGAN

STATE OF PROFESSIONAL SURVEYORS, JAN. 28, 1971
REVISED MAY 14, 1978
REVISED JAN. 1989
REVISED OCT. 19