

SURVEY & REMONUMENTATION

FEB 13 1998

SECTION

LAND CORNER RECORDATION CERTIFICATE Filing Requirement of Act 74, Mich. P.A. 1970

For corners in

KALKASKA

(County)

1997 REMONUMENTATION

1. Public Land Survey

Located In:

Corner Code #

T 26N R 8W

K-13

T R

T 25N R 8W

K-1

T R

2. Property Controlling
in Section

S T R

S T R

3. Miscellaneous
Property in Sec.

S T R

S T R

Register of Deeds Stamp & File Number

4. Lot No. _____, Recorded Plat _____

5. Private Claims _____

	A	B	C	D	E	F	G	H	I	J	K	L	M
1													
2		6		5		4		3		2		1	
3													
4		7		8		9		10		11		12	
5													
6		18		17		16		15		14		13	
7													
8		19		20		21		22		23		24	
9													
10		30		29		28		27		26		25	
11													
12		31		32		33		34		35		36	
13													

I, EUGENE FARRIER, in a field survey on OCTOBER 15, 1997

do hereby state that under requirements of P.A. 74, Michigan P.A. of 1970, the corner points mentioned in lines 1 and 2 above were in conformance with regulations and rules therefore as required in the current manual of survey instructions of the United States Department of the Interior, Bureau of Land Management or by a decree of a Court of Law and /or that the corner points mentioned in lines 3, 4 and 5 above were in conformance with the rules of the Michigan Board of Land Surveyors or by a Decree of a Court of Law; established, re-established, monumented, recovered, found as expressed below:

NOTE: Not more than 2 corners, all in the same town and range, may be recorded on this certificate.

A. Description of original monument and accessories and/or subsequent restoration:

K-13: Cor. Common to Sec. 35 & 36, T26N-R8W, Boardman Township, Sec. 1 & 2, T25N-R8W, Springfield Township. 1852, GLO resurvey, set post, 6" Beech N73E 12, 12" Beech N23W 80 July 1911, W.S. Merrill, Co. Surveyor, noted cor., no accessories 11-01-1986, Farrier Surveying, L.C.R., Lib. 2, Pg. 293. Fd. 1/2" iron w/accessories 08-06-1993, Farrier Surveying, survey, fd. 1/2" iron w/accessories

B. Description of corner evidence found and/or method applied in restoring or reestablishing corner:

K-13: Cor. Common to Sec. 35 & 36, T26N-R8W, Boardman Township, Sec. 1 & 2, T25N-R8W, Springfield Township. Fd. 1/2" x 18" re-rod w/accessories. Pulled & replaced with 5/8" x 18" re-rod w/brass cap in (Inman Rd.) C.L. 2-track (East-West) & in C.L. Trail Rd. N-S. No GLO witnesses were found. The Kalkaska Co. Peer group approved & accepted the above monument as accepted as the best available evidence of the position of the original corner.


C. Description of monument for corner and accessories established to perpetuate locating the position of the corner:

K-13: Cor. Common to Sec. 35 & 36, T26N-R8W, Boardman Township, Sec. 1 & 2, T25N-R8W, Springfield Township. Fd. 1/2" x 18" re-rod w/accessories. Pulled & replaced with 5/8" x 18" re-rod w/brass cap in (Inman Rd.) C.L. 2-track (East-West) & in C.L. Trail Rd. N-S Set nail & tag N15W, 16" R. Pine 39.86' Set nail & tag N45E, 14" Cherry 66.75' Set nail & tag N78E, 14" Tw. Cherry 70.23 Fd. nail S46E 6" Cherry 21.21

Ratified by Peer Group
P.A. 345 - 1990 Kalkaska County

Chairman Eugene Farrier

Date 1-29-98

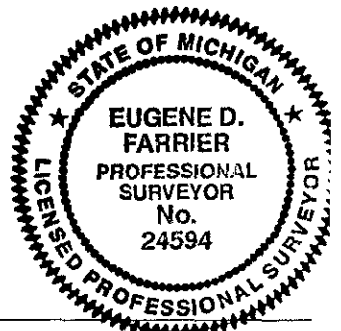

Signed by Eugene Farrier
Surveyor's Michigan License No. 24594

Date 2-3-98



3004868
Page: 1 of 1
02/04/98 11:22f
IR. 5 DC. 272