

# SURVEY & REMONUMENTATION

FEB 13 1998

## SECTION

## LAND CORNER RECORDATION CERTIFICATE Filing Requirement of Act 74, Mich. P.A. 1970

For corners in

<u>KALKASKA</u>	Located In:	Corner Code #	
(County)			
1997 REMONUMENTATION			
1. Public Land Survey	T <u>26N</u> R <u>8W</u>	<u>L-5</u>	
	T _____ R _____	_____	
	T _____ R _____	_____	
	T _____ R _____	_____	
2. Property Controlling in Section	S _____ T _____ R _____	_____	
	S _____ T _____ R _____	_____	
3. Miscellaneous Property in Sec.	S _____ T _____ R _____	_____	
	S _____ T _____ R _____	_____	

Register of Deeds Stamp & File Number

4. Lot No. \_\_\_\_\_, Recorded Plat \_\_\_\_\_

5. Private Claims \_\_\_\_\_


	A	B	C	D	E	F	G	H	I	J	K	L	M
1													
2	6		5		4		3		2		1		
3													
4	7		8		9		10		11		12		
5													
6	18		17		16		15		14		13		
7													
8	19		20		21		22		23		24		
9													
10	30		29		28		27		26		25		
11													
12	31		32		33		34		35		36		
13													

I, EUGENE FARRIER, in a field survey on OCTOBER 24, 1997 do hereby state that under requirements of P.A. 74, Michigan P.A. of 1970, the corner points mentioned in lines 1 and 2 above were in conformance with regulations and rules therefore as required in the current manual of survey instructions of the United States Department of the Interior, Bureau of Land Management or by a decree of a Court of Law and /or that the corner points mentioned in lines 3, 4 and 5 above were in conformance with the rules of the Michigan Board of Land Surveyors or by a Decree of a Court of Law; established, re-established, monumented, recovered, found as expressed below:

**NOTE:** Not more than 2 corners, all in the same town and range, may be recorded on this certificate.

**A. Description of original monument and accessories and/or subsequent restoration:**

L-5: 1/4 Cor. Common to Sec. 12 & 13, T26N-R8W, Boardman Township  
 1852, GLO resurvey, set cor. 6" Beech S35E, 22, 12" Beech N15W, 64  
 06-21-1973, P.G. Perla #5942, Cert. Survey, fd. 1 1/2" iron pipe, w/accessories  
 11-07-1974, Granger Eng. Inc., Cert. Survey, Fd. Iron, w/accessories, Lib. 1, Pg. 632  
 07-14-1975, J.L. Wilcox & Assoc. Inc., LCR, fd. Iron & cap, w/accessories, Lib. 1, Pg. 355  
 10-30-1975, J.L. Wilcox & Assoc. Inc., Cert. Survey, fd. Iron & cap, w/accessories, Lib. 1, Pg. 891  
 12-16-1977, J.L. Wilcox & Assoc. Inc., Cert. Survey, fd. Iron & cap, w/accessories, Lib. 2, Pg. 154  
 03-13-1981, W.B. Batzer Jr. #13026, Cert. Survey, Fd. Iron & cap, w/accessories, Lib. 2, Pg. 641  
 12-18-1982, Farrier Surveying, Cert. Survey (witnesses Lib. 2, Pg. 154)

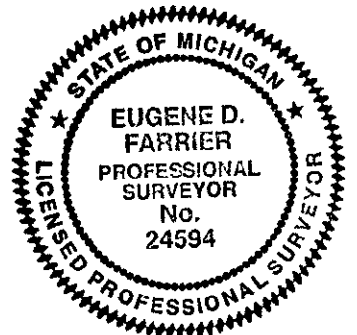

**B. Description of corner evidence found and/or method applied in restoring or reestablishing corner:**

L-5: 1/4 Cor. Common to Sec. 12 & 13, T26N-R8W, Boardman Township  
 Fd. 5/8" x 26" rebar w/cap #5942 in CL Bass Lake Rd. Pulled and fd. 1 1/2" iron pipe. Pulled and replaced with 5/8" x 18" rebar, w/brass cap. No GLO witnesses were fd. The Kalkaska Co. Peer group approved & accepted the above monument as the best available evidence of the position of the original corner.

**C. Description of monument for corner and accessories established to perpetuate locating the position of the corner:**

L-5: 1/4 Cor. Common to Sec. 12 & 13, T26N-R8W, Boardman Township  
 Fd. 5/8" x 26" rebar w/cap #5942 in CL Bass Lake Rd. Pulled and fd. 1 1/2" iron pipe. Pulled and replaced with 5/8" x 18" rebar, w/brass cap.  
 Set nail & tag North, 4" Cherry, 53.94'  
 Set nail & tag N80E, P. Pole, 145.07'  
 Set nail & tag S72W, wood fence post, 89.34'  
 Set nail & tag N77W, P. Pole, 220.65'

Ratified by Peer Group  
 P.A. 345 - 1990 Kalkaska County  
 Chairman Eugene Farrier  
 Date 1-29-98

Signed by Eugene Farrier  
 Surveyor's Michigan License No. 24594

Date 2-3-98



**3004871**  
 Page: 1 of 1  
 02/04/98 11:22f