

SURVEY & REMONUMENTATION

FEB 13 1998

SECTION

LAND CORNER RECORDATION CERTIFICATE Filing Requirement of Act 74, Mich. P.A. 1970

For corners in

<u>KALKASKA</u>	Located In:	Corner Code #	
(County)			
1997 REMONUMENTATION			
1. Public Land Survey	T <u>26N</u> R <u>8W</u>	L- <u>9</u>	
	T _____ R _____	_____	
	T _____ R _____	_____	
	T _____ R _____	_____	
2. Property Controlling in Section	S _____ T _____ R _____	_____	
	S _____ T _____ R _____	_____	
3. Miscellaneous Property in Sec.	S _____ T _____ R _____	_____	
	S _____ T _____ R _____	_____	

Register of Deeds Stamp & File Number

4. Lot No. _____, Recorded Plat _____

5. Private Claims _____

	A	B	C	D	E	F	G	H	I	J	K	L	M
1													
2		6		5		4		3		2		1	
3													
4		7		8		9		10		11		12	
5													
6		13		17		16		15		14		13	
7													
8		19		20		21		22		23		24	
9													
10		30		29		28		27		26		25	
11													
12		31		32		33		34		35		36	
13													

I, EUGENE FARRIER, in a field survey on OCTOBER 15, 1997 do hereby state that under requirements of P.A. 74, Michigan P.A. of 1970, the corner points mentioned in lines 1 and 2 above were in conformance with regulations and rules therefore as required in the current manual of survey instructions of the United States Department of the Interior, Bureau of Land Management or by a decree of a Court of Law and for that the corner points mentioned in lines 3, 4 and 5 above were in conformance with the rules of the Michigan Board of Land Surveyors or by a Decree of a Court of Law; established, re-established, monumented, recovered, found as expressed below:


NOTE: Not more than 2 corners, all in the same town and range, may be recorded on this certificate.

A. Description of original monument and accessories and/or subsequent restoration:
L-9: Cor. Common to Sec. 24 & 25, T26N-R8W, Boardman Township
 1852, GLO resurvey, set post, 7" Beech S30W, 10, 10" Sugar N40W 37
 05-16-1887, E. Mosher Co. Surveyor, used corner, no accessories
 04-27-1901, W.S. Merrill, Co. Surveyor, Fd. Stump G.L.O. B.T. Fd. old stake, set iron gas pipe
 11-12-1976, J.L. Wilcox #14102, survey & L.C.R. Lib. 2, Pg. 8, Fd. 2" pipe w/accessories
 08-30-1985, Farrier Surveying, survey, Fd. 2" pipe w/accessories
 05-30-1987, Farrier Surveying, survey, Fd. 2" pipe w/ accessories
 11-21-1989, Farrier Surveying, survey, Fd. 2" pipe w/accessories

B. Description of corner evidence found and/or method applied in restoring or reestablishing corner:
L-9: Cor. Common to Sec. 24 & 25, T26N-R8W, Boardman Township
 Fd. 2" iron pipe w/accessories. Pulled & replaced with 5/8" x 18" re-rod w/brass cap in C.L. Hall Rd. No GLO witnesses were found. The Kalkaska Co. peer group approved & accepted the above monument as a careful and faithful perpetuation of the position of the original corner.

C. Description of monument for corner and accessories established to perpetuate locating the position of the corner:
L-9: Cor. Common to Sec. 24 & 25, T26N-R8W, Boardman Township
 Fd. 2" iron pipe w/accessories. Pulled & replaced with 5/8" x 18" re-rod w/brass cap in C.L. Hall Rd.
 Set nail & tag N23W 10" S. Pine 48.86'
 Set nail & tag N70E P.Pole 87.73'
 Set nail & tag South iron & cap #24594 33.00'
 Set nail & tag N60W 5" S. Pine 51.90

Ratified by Peer Group
 P.A. 345 - 1990 Kalkaska County
 Chairman Eugene Farrier
 Date 1-29-98

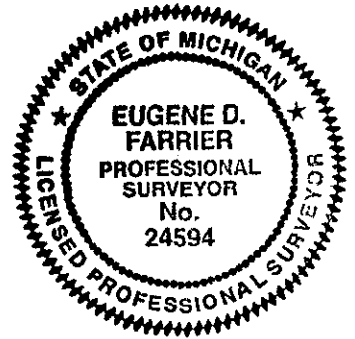

Signed by Eugene Farrier
 Surveyor's Michigan License No. 24594

Date 2-3-98



3004873
 Page: 1 of 1
 02/04/98 11:22f