

**SURVEY &  
REMONUMENTATION**

**FEB 13 1998**

**SECTION**

**LAND CORNER RECORDATION CERTIFICATE  
Filing Requirement of Act 74, Mich. P.A. 1970**

For corners in

<u>KALKASKA</u>	Located In:	Corner Code #
(County)		
<b>1997 REMONUMENTATION</b>		
1. Public Land Survey	T <u>26N</u> R <u>8W</u>	<u>L-11</u>
	T _____ R _____	_____
	T _____ R _____	_____
	T _____ R _____	_____
2. Property Controlling in Section	S _____ T _____ R _____	_____
	S _____ T _____ R _____	_____
3. Miscellaneous Property in Sec.	S _____ T _____ R _____	_____
	S _____ T _____ R _____	_____

Register of Deeds Stamp & File Number

4. Lot No. \_\_\_\_\_, Recorded Plat \_\_\_\_\_

5. Private Claims \_\_\_\_\_

I, EUGENE FARRIER, in a field survey on OCTOBER 27, 1997 do hereby state that under requirements of P.A. 74, Michigan P.A. of 1970, the corner points mentioned in lines 1 and 2 above were in conformance with regulations and rules therefore as required in the current manual of survey instructions of the United States Department of the Interior, Bureau of Land Management or by a decree of a Court of Law and /or that the corner points mentioned in lines 3, 4 and 5 above were in conformance with the rules of the Michigan Board of Land Surveyors or by a Decree of a Court of Law; established, re-established, monumented, recovered, found as expressed below:

**NOTE: Not more than 2 corners, all in the same town and range, may be recorded on this certificate.**


	A	B	C	D	E	F	G	H	I	J	K	L	M
1													
2	6		5		4		3		2		1		
3													
4	7		8		9		10		11		12		
5													
6	18		17		16		15		14		13		
7													
8	19		20		21		22		23		24		
9													
10	30		29		28		27		26		25		
11													
12	31		32		33		34		35		36		
13													

A. Description of original monument and accessories and/or subsequent restoration:  
**L-11: 1/4 Cor. Common to Sec. 25 & 36, T26N-R8W, Boardman Township**  
 1852, GLO resurvey, set post, 36" Y. Birch S45E, 12  
 04-27-1901, W.S. Merrill, Co. Surveyor, iron stake and one GLO bearing tree  
 08-15-1901, County Surveyor, used cor., w/accessories  
 05-28-1987, Farrier Surveying, LCR, fd. 1" pipe, w/accessories, Lib. 2, Pg. 323  
 05-30-1987, Farrier Surveying, Cert. Survey, fd. 1" pipe in fence cor. (W.S. Merrill Co. Surveyor 1901), w/accessories  
 11-21-1989, Farrier Surveying, Cert. Survey, fd. 1" pipe, w/accessories  
 09-08-1992, Grand Traverse Surveying Co., Cert. Survey, fd. 1 1/4" iron pipe, w/accessories

B. Description of corner evidence found and/or method applied in restoring or reestablishing corner:  
**L-11: 1/4 Cor. Common to Sec. 25 & 36, T26N-R8W, Boardman Township**  
 Fd. 1" iron pipe in old fence cor. Pulled and replaced with 5/8" x 18" rebar, w/aluminum cap. No GLO witnesses found. The Kalkaska Co. Peer group approved the above monument as careful and faithful perpetuation of the position of the original corner.

C. Description of monument for corner and accessories established to perpetuate locating the position of the corner:  
**L-11: 1/4 Cor. Common to Sec. 25 & 36, T26N-R8W, Boardman Township**  
 Fd. 1" iron pipe in old fence cor. Pulled and replaced with 5/8" x 18" rebar, w/aluminum cap.  
 Set nail and tag, N05E, 8" Cherry, 64.98'  
 Set nail and tag, S09W, 16" Tw. Maple, 41.86'  
 Set nail and tag, S48W, 8" Maple, 42.73'  
 Set nail and tag, N85W, 10" Maple, 31.10'

Ratified by Peer Group  
 P.A. 345 - 1990 Kalkaska County  
 Chairman Eugene Farrier  
 Date 1-29-98

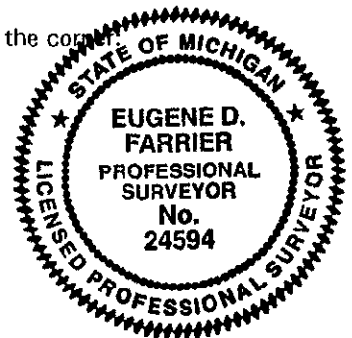

Signed by Eugene Farrier  
 Surveyor's Michigan License No. 24594

Date 2-3-98



**3004874**  
 Page: 1 of 1  
 02/04/98 11:22f