

**SURVEY &
REMONUMENTATION**

FEB 13 1998

**SECTION LAND CORNER RECORDATION CERTIFICATE
Filing Requirement of Act 74, Mich. P.A. 1970**

For corners in

<u>KALKASKA</u>	Located In:	Corner Code #
(County)		
1997 REMONUMENTATION		
1. Public Land Survey	T <u>26N</u> R <u>8W</u>	<u>M-2</u>
	T _____ R _____	_____
	T _____ R _____	_____
	T _____ R _____	_____
2. Property Controlling	S _____ T _____ R _____	_____
in Section	S _____ T _____ R _____	_____
3. Miscellaneous	S _____ T _____ R _____	_____
Property in Sec.	S _____ T _____ R _____	_____

Register of Deeds Stamp & File Number

4. Lot No. _____, Recorded Plat _____

5. Private Claims _____

I, EUGENE FARRIER, in a field survey on OCTOBER 24, 1997 do hereby state that under requirements of P.A. 74, Michigan P.A. of 1970, the corner points mentioned in lines 1 and 2 above were in conformance with regulations and rules therefore as required in the current manual of survey instructions of the United States Department of the Interior, Bureau of Land Management or by a decree of a Court of Law and for that the corner points mentioned in lines 3, 4 and 5 above were in conformance with the rules of the Michigan Board of Land Surveyors or by a Decree of a Court of Law; established, re-established, monumented, recovered, found as expressed below:

A	B	C	D	E	F	G	H	I	J	K	L	M
1												
2	6		5		4		3		2		1	
3												
4	7		8		9		10		11		12	
5												
6	18		17		16		15		14		13	
7												
8	19		20		21		22		23		24	
9												
10	30		29		28		27		26		25	
11												
12	31		32		33		34		35		36	
13												


NOTE: Not more than 2 corners, all in the same town and range, may be recorded on this certificate.

A. Description of original monument and accessories and/or subsequent restoration:
M-2: East 1/4 cor. Sec. 1, T26N-R8W, Boardman Township
 1852, GLO resurvey, set post, 8" Beech, N10W, 11, 10" Beech S18W, 32
 06-13-1902, County Surveyor, used cor., no accessories
 10-26-1982, A.L. Drago #3921, Cert. Survey, Fd. 1/2" rod in 1 1/4" pipe, w/accessories, Lib. 2, Pg. 741
 05-12-1987, DNR, LCR, fd. L.S. Gene Farriers 1/2" rod in pipe. Fits 1902 WS Merrill survey of Sec. 1 (incl. Section subn.). Merrill had both U.S. B.T.'s & Farriers notes indicate one U.S. B.T. possibly still evident, w/accessories, Lib. 2, Pg. 350
 06-06-1992, Grand Traverse Surveying Co., Cert. Survey, fd. 1/2" rerod #24594 inside a 1 1/2" pipe, no accessories, Lib. 4, Pg. 77

B. Description of corner evidence found and/or method applied in restoring or reestablishing corner:
M-2: East 1/4 cor. Sec. 1, T26N-R8W, Boardman Township
 Fd. 1/2" x 18" rebar & cap #14102, inside 1 1/2" iron pipe. Pulled and replaced with 5/8" x 18' rebar, w/aluminum cap. No GLO witnesses were fd. The Kalkaska Co. Peer group approved the above monument as a careful and faithful perpetuation of the position of the original corner.

C. Description of monument for corner and accessories established to perpetuate locating the position of the corner:
M-2: East 1/4 cor. Sec. 1, T26N-R8W, Boardman Township
 Fd. 1/2" x 18" rebar & cap #14102, inside 1 1/2" iron pipe. Pulled and replaced with 5/8" x 18' rebar, w/aluminum cap.
 Set nail & tag N18E, 5" W. Pine, 17.34'
 South, DNR mon. (W 1/4 cor. Sec. 6, T26N-R7W), 21.95' (Closing corner)
 Set nail & tag S55W, 14" Tw. Hemlock, 36.78'
 Set nail & tag S77W, 13" Maple, 27.15'

Ratified by Peer Group
 P.A. 345 - 1990 Kalkaska County
 Chairman Eugene Farrier
 Date 1-29-98

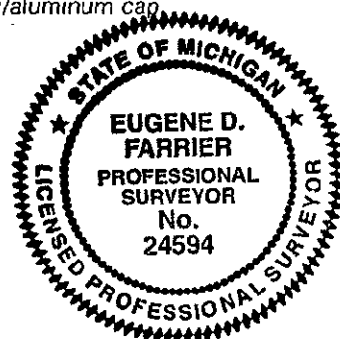

Signed by Eugene Farrier
 Surveyor's Michigan License No. 24594

Date 2-3-98



3004877
 Page: 1 of 1
 02/04/98 11:22