

# SURVEY & REMONUMENTATION

FEB 13 1998

## SECTION

### LAND CORNER RECORDATION CERTIFICATE Filing Requirement of Act 74, Mich. P.A. 1970

For corners in

<u>KALKASKA</u>	Located In:	Corner Code #
(County)		
1997 REMONUMENTATION		
1. Public Land Survey	T <u>26N</u> R <u>8W</u>	<u>M-4</u>
	T <u>   </u> R <u>   </u>	<u>   </u>
	T <u>   </u> R <u>   </u>	<u>   </u>
	T <u>   </u> R <u>   </u>	<u>   </u>
2. Property Controlling in Section	S <u>   </u> T <u>   </u> R <u>   </u>	<u>   </u>
	S <u>   </u> T <u>   </u> R <u>   </u>	<u>   </u>
3. Miscellaneous Property in Sec.	S <u>   </u> T <u>   </u> R <u>   </u>	<u>   </u>
	S <u>   </u> T <u>   </u> R <u>   </u>	<u>   </u>

Register of Deeds Stamp & File Number

4. Lot No. \_\_\_\_\_, Recorded Plat \_\_\_\_\_  
5. Private Claims \_\_\_\_\_


	A	B	C	D	E	F	G	H	I	J	K	L	M
1													
2	6		5		4		3		2		1		
3													
4	7		8		9		10		11		12		
5													
6	10		17		16		15		14		13		
7													
8	19		20		21		22		23		24		
9													
10	30		29		28		27		26		25		
11													
12	31		32		33		34		35		36		
13													

I, EUGENE FARRIER, in a field survey on AUGUST 8, 1997 do hereby state that under requirements of P.A. 74, Michigan P.A. of 1970, the corner points mentioned in lines 1 and 2 above were in conformance with regulations and rules therefore as required in the current manual of survey instructions of the United States Department of the Interior, Bureau of Land Management or by a decree of a Court of Law and /or that the corner points mentioned in lines 3, 4 and 5 above were in conformance with the rules of the Michigan Board of Land Surveyors or by a Decree of a Court of Law; established, re-established, monumented, recovered, found as expressed below:

**NOTE:** Not more than 2 corners, all in the same town and range, may be recorded on this certificate.

A. Description of original monument and accessories and/or subsequent restoration:  
M-4: E 1/4 Cor. Sec. 12, T26N-R8W, Boardman Township  
1852, GLO resurvey, set post, 10" Beech, N10W 19, 24" Sugar, S73W 19  
01-29-1988, Farrier Surveying, Cert. survey, Fd. 1 1/4" iron pipe 2' below surface, raised with 1/2" rerod & cap, no accessories, Lib. 3, Pg. 475

B. Description of corner evidence found and/or method applied in restoring or reestablishing corner:  
M-4: E 1/4 Cor. Sec. 12, T26N-R8W, Boardman Township  
Fd. 1/2" x 18" rebar w/cap #24594. Pulled & replaced with 5/8" x 18" rebar (over 1 1/4" I.P.) w/brass cap in C/L N-S trail Rd. No GLO witnesses were fd. The Kalkaska Co. Peer group approved the above monument as a careful and faithful reestablishment of the original corner.

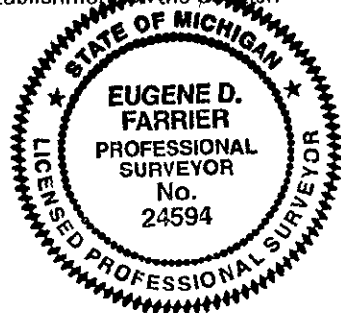

C. Description of monument for corner and accessories established to perpetuate locating the position of the corner:  
M-4: E 1/4 Cor. Sec. 12, T26N-R8W, Boardman Township  
Fd. 1/2" x 18" rebar w/cap #24594. Pulled & replaced with 5/8" x 18" rebar (over 1 1/4" I.P.) w/brass cap in C/L N-S trail Rd. No GLO witnesses were fd.  
Set nail & tag N75E, 12" Maple 43.48'  
South, Kalkaska Co. Mon. 56.02' (Closing corner).  
Fd. nail S60W, 16" Tw. Birch 43.75'  
Fd. nail West, 3" W. Pine 41.13'

Ratified by Peer Group  
P.A. 345 - 1990 Kalkaska County  
Chairman Eugene Farrier  
Date 1-29-98

Signed by Eugene Farrier  
Michigan License No. 24594

Date 2-3-98 Surveyor's



3004879  
Page: 1 of 1  
02/04/98 11:22f