

SURVEY & REMONUMENTATION

FEB 13 1998

SECTION

LAND CORNER RECORDATION CERTIFICATE Filing Requirement of Act 74, Mich. P.A. 1970

For corners in

KALKASKA	Located in:	Corner Code #	
(County)			
1997 REMONUMENTATION			
1. Public Land Survey	T. <u>26N</u> R. <u>8W</u>	<u>M-6</u>	
	T. _____ R. _____	_____	
	T. _____ R. _____	_____	
	T. _____ R. _____	_____	
2. Property Controlling in Section	S. _____ T. _____ R. _____	_____	
	S. _____ T. _____ R. _____	_____	
3. Miscellaneous Property in Sec.	S. _____ T. _____ R. _____	_____	
	S. _____ T. _____ R. _____	_____	

Register of Deeds Stamp & File Number

4. Lot No. _____, Recorded Plat _____

5. Private Claims _____

	A	B	C	D	E	F	G	H	I	J	K	L	M
1													
2	6		5		4		3		2		1		
3													
4	7		8		9		10		11		12		
5													
6	18		17		16		15		14		13		
7													
8	19		20		21		22		23		24		
9													
10	30		29		28		27		26		25		
11													
12	31		32		33		34		35		36		
13													

I, EUGENE FARRIER, in a field survey on AUGUST 08, 1997 do hereby state that under requirements of P.A. 74, Michigan P.A. of 1970, the corner points mentioned in lines 1 and 2 above were in conformance with regulations and rules therefore as required in the current manual of survey instructions of the United States Department of the Interior, Bureau of Land Management or by a decree of a Court of Law and for that the corner points mentioned in lines 3, 4 and 5 above were in conformance with the rules of the Michigan Board of Land Surveyors or by a Decree of a Court of Law; established, re-established, monumented, recovered, found as expressed below:


NOTE: Not more than 2 corners, all in the same town and range, may be recorded on this certificate.

A. Description of original monument and accessories and/or subsequent restoration:
M-6: E 1/4 Cor. Sec. 13, T26N-R8W, Boardman Township
 1852, GLO resurvey, set post, 6" Sugar, S71W 08, 8" Sugar, S45W 08
 08-27-1895, E.B. Dennis, Co. Surveyor, used cor., no accessories
 July 1975, J.L. Wilcox #14102, LCR, set 1/2" rod w/accessories, Lib. 1, Pg. 355
 07-03-1975, J.L. Wilcox & Associates Inc., Cert. survey, set 1/2" rod w/accessories, Lib. 2, Pg. 154
 03-13-1981, W.B. Batzer #13026, Cert. Survey, fd. Iron w/accessories, Lib. 2, Pg. 641
 09-07-1984, Farrier Surveying, Cert. survey #8684A, Fd: 1/2" iron & cap #14102 w/accessories(wit. in Lib.13, Pg.355)
 09-19-1984, Farrier Surveying, Cert. survey #8684B, Fd: 1/2" iron & cap #14102 w/accessories(wit. in Lib.13, Pg.355)
 04-29-1993 Grand Traverse Surveying Co., Cert. survey, noted cor., no accessories, Lib.4, Pg.281

B. Description of corner evidence found and/or method applied in restoring or reestablishing corner:
M-6: E 1/4 Cor. Sec. 13, T26N-R8W, Boardman Township
 Fd. 1/2" x 18" iron in C/L Puffer Rd. Pulled & replaced with 5/8" x 18" rebar w/brass cap. No GLO witnesses were fd. The Kalkaska Co. Peer group approved and accepted the above monument as a careful and faithful reestablishment of the position of the original corner.

C. Description of monument for corner and accessories established to perpetuate locating the position of the corner:
M-5: E 1/4 Cor. Sec. 13, T26N-R8W, Boardman Township
 Fd. 1/2" x 18" iron in C/L Puffer Rd. Pulled & replaced with 5/8" x 18" rebar w/brass cap.
 Fd. spike S60E, 10" Maple 21.70'
 South, Kalkaska Co. Mon. 20.80'
 Fd. spike S68W, 14" Beech 26.54'
 Fd. spike N57W, 13" Beech 34.39'

Monumented by Peer Group
 P.A. 345 - 1990 Kalkaska County
 Chairman Eugene Farrier
 Date 7-29-98

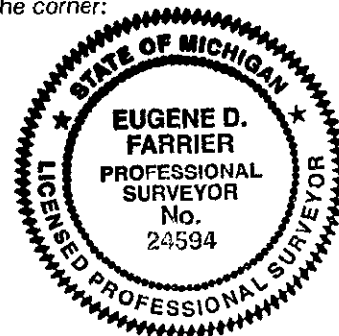

Signed by Eugene Farrier
 Surveyor's Michigan License No. 24594

Date 2-3-98



3004881
 Page: 1 of 1
 02/04/98 11:22