

**SURVEY &
REMONUMENTATION**

FEB 13 1998

SECTION

**LAND CORNER RECORDATION CERTIFICATE
Filing Requirement of Act 74, Mich. P.A. 1970**

For corners in

<u>KALKASKA</u>	Located In:	Corner Code #
(County)		
1997 REMONUMENTATION		
1. Public Land Survey	T <u>26N</u> R <u>8W</u>	<u>M-8</u>
	T _____ R _____	_____
	T _____ R _____	_____
	T _____ R _____	_____
2. Property Controlling	S _____ T _____ R _____	_____
in Section	S _____ T _____ R _____	_____
3. Miscellaneous	S _____ T _____ R _____	_____
Property in Sec.	S _____ T _____ R _____	_____

Register of Deeds Stamp & File Number

4. Lot No. _____, Recorded Plat _____

5. Private Claims _____

1	A	B	C	D	E	F	G	H	I	J	K	L	M
2		6		5		4		3		2		1	
3													
4		7		8		9		10		11		12	
5													
6		10		17		16		15		14		13	
7													
8		19		20		21		22		23		24	
9													
10		30		29		28		27		26		25	
11													
12		31		32		33		34		35		36	
13													

I, EUGENE FARRIER, in a field survey on OCTOBER 28, 1997 do hereby state that under requirements of P.A. 74, Michigan P.A. of 1970, the corner points mentioned in lines 1 and 2 above were in conformance with regulations and rules therefore as required in the current manual of survey instructions of the United States Department of the Interior, Bureau of Land Management or by a decree of a Court of Law and/or that the corner points mentioned in lines 3, 4 and 5 above were in conformance with the rules of the Michigan Board of Land Surveyors or by a Decree of a Court of Law; established, re-established, monumented, recovered, found as expressed below:

NOTE: Not more than 2 corners, all in the same town and range, may be recorded on this certificate.

A. Description of original monument and accessories and/or subsequent restoration:

M-8: East 1/4 cor. Sec. 24, T26N-R8W, Boardman Township
1852, GLO resurvey, set post, 12" Beech, N13W, 47, 18" Elm, S72W, 14
07-08-1991, Farrier Surveying, Cert. Survey, fd. 1" boat spike, w/accessories
10-21-1996, Farrier Surveying, Cert. Survey, fd. 1" boat spike, w/accessories


B. Description of corner evidence found and/or method applied in restoring or reestablishing corner:

M-8: East 1/4 cor. Sec. 24, T26N-R8W, Boardman Township
Fd. Boat spike 1' West C.L. Puffer Rd. Pulled and replaced with 5/8" x 18" rebar, w/brass cap in mon. box. No GLO witnesses were fd. The Kalkaska Co. Peer group approved and accepted the above monument as the best available evidence of the position of the original corner.

Ratified by Peer Group
P.A. 345 - 1990 Kalkaska County
Chairman Eugene Farrier
Date 1-29-98

C. Description of monument for corner and accessories established to perpetuate locating the position of the corner:

M-8: East 1/4 cor. Sec. 24, T26N-R8W, Boardman Township
Fd. Boat spike 1' West C.L. Puffer Rd. Pulled and replaced with 5/8" x 18" rebar, w/brass cap in mon. box.
Fd. Nail N25W, P. Pole, 97.75'
South, Kalkaska Co. mon. (W. 1/4 cor. Sec. 19, T26N-R7W), 89.91' (Closing corner)
West, iron & cap #12581, 32.95'
West, iron & cap #24594, 272.91'

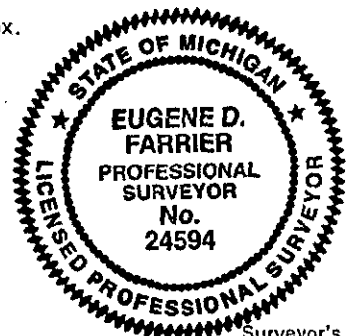

Signed by Eugene Farrier
Michigan License No. 24594

Date 2-3-98 Surveyor's



3004883
Page: 1 of 1
02/04/98 11:22f