

**SURVEY &
REMONUMENTATION**

FEB 13 1998

SECTION

**LAND CORNER RECORDATION CERTIFICATE
Filing Requirement of Act 74, Mich. P.A. 1970**

For corners in

KALKASKA Located In: Corner Code #
(County)
1997 REMONUMENTATION
1. Public Land Survey T 26N R 8W M-9
T R
T R
T R
2. Property Controlling S T R
in Section S T R
3. Miscellaneous S T R
Property in Sec. S T R

Register of Deeds Stamp & File Number


4. Lot No. _____, Recorded Plat _____
5. Private Claims _____

	A	B	C	D	E	F	G	H	I	J	K	L	M
1													
2	6		5		4		3		2		1		
3													
4	7		8		9		10		11		12		
5													
6	18		17		16		15		14		13		
7													
8	19		20		21		22		23		24		
9													
10	30		29		28		27		26		25		
11													
12	31		32		33		34		35		36		
13													

I, EUGENE FARRIER, in a field survey on OCTOBER 28, 1997 do hereby state that under requirements of P.A. 74, Michigan P.A. of 1970, the corner points mentioned in lines 1 and 2 above were in conformance with regulations and rules therefore as required in the current manual of survey instructions of the United States Department of the Interior, Bureau of Land Management or by a decree of a Court of Law and /or that the corner points mentioned in lines 3, 4 and 5 above were in conformance with the rules of the Michigan Board of Land Surveyors or by a Decree of a Court of Law; established, re-established, monumented, recovered, found as expressed below:

NOTE: Not more than 2 corners, all in the same town and range, may be recorded on this certificate.

A. Description of original monument and accessories and/or subsequent restoration:
M-9: Sec. Cor. Common to Sec. 24 & 25, T26N-R8W, Boardman Township
1852, GLO resurvey, set post, 18" Sugar N27W, 14, 26" Sugar S32W, 17
05-16-1889, E. Mosher Co. Surveyor, used cor., no accessories
04-27-1901, W.S. Merrill Co. Surveyor, fd. Old stake & accessory
11-12-1976, J.L. Wilcox #14102, Cert. Survey, fd. 1/2" iron, w/accessories, Lib. 1, Pg. 961
11-12-1976, J.L. Wilcox #14102, LCR, fd. 1/2" iron, w/accessories, Lib. 2, Pg. 8
05-05-1978, J.L. Wilcox #14102, Cert. Survey, used cor., w/accessories, Lib. 2, Pg. 298
11-17-1981, N.B. Deyoung #20705, Cert. Survey, fd. 1/2" iron rod, w/accessories
07-09-1982, Farrier Surveying, Cert. Survey, fd. 1/2" rod, w/accessories, Lib. 2, Pg. 813
11-21-1989, Farrier Surveying, Cert. Survey, fd. 1/2" rod, w/accessories
10-21-1996, Farrier Surveying, Cert. Survey, fd. 1/2" rod, w/accessories

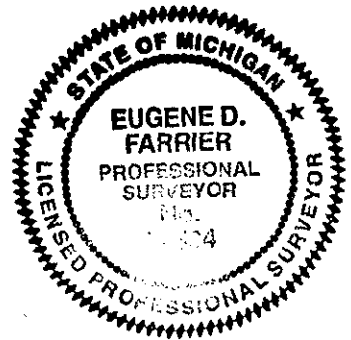

B. Description of corner evidence found and/or method applied in restoring or reestablishing corner:
M-9: Sec. Cor. Common to Sec. 24 & 25, T26N-R8W, Boardman Township
Fd. 1/2" iron 0.5' East of C.L. Puffer Rd. & 28' N. Of C.L. Hall Rd. To West pulled & replaced with 5/8" x 18" rebar, w/brass cap in mon. box. No GLO witnesses were fd. The Kalkaska Co. Peer group approved the above monument as the best available evidence of the position of the original corner.

C. Description of monument for corner and accessories established to perpetuate locating the position of the corner:
M-9: Sec. Cor. Common to Sec. 24 & 25, T26N-R8W, Boardman Township
Fd. 1/2" iron 0.5' East of C.L. Puffer Rd. & 28' N. Of C.L. Hall Rd. To West pulled & replaced with 5/8" x 18" rebar, w/brass cap in mon. box.
Fd. Nail S51W face P. Pole, 117.45'
Set nail & tag S25W W. Post, 164.50'
Fd. S60W stop sign, 84.15'
Fd. S02W 1/2" iron, 116.29'
Fd. Nail N35W Post, 47.17'
South, Standard Co. Mon., 116.24' (Closing corner)

Ratified by Peer Group
P.A. 345 - 1990 Kalkaska County
Chairman Eugene Farrier
Date 1-29-98

Signed by Eugene Farrier
Surveyor's Michigan License No. 24594

Date 2-3-98



3004884
Page: 1 of 1
02/04/98 11:22f