

SURVEY & REMONUMENTATION

FEB 13 1998

LAND CORNER RECORDATION CERTIFICATE Filing Requirement of Act 74, Mich. P.A. 1970

SECTION

For corners in

KALKASKA
(County)
1997 REMONUMENTATION
1. Public Land Survey

Located In:

Corner Code #

T 26N R 8W
T ___ R ___
T ___ R ___
T ___ R ___
S ___ T ___ R ___
S ___ T ___ R ___
S ___ T ___ R ___
S ___ T ___ R ___

M-10

2. Property Controlling
in Section
3. Miscellaneous
Property in Sec.

4. Lot No. _____, Recorded Plat _____

5. Private Claims _____


Register of Deeds Stamp & File Number

I, EUGENE FARRIER, in a field survey on OCTOBER 29, 1997
do hereby state that under requirements of P.A. 74, Michigan P.A. of 1970, the corner points mentioned in lines 1 and 2 above were in conformance with regulations and rules therefore as required in the current manual of survey instructions of the United States Department of the Interior, Bureau of Land Management or by a decree of a Court of Law and /or that the corner points mentioned in lines 3, 4 and 5 above were in conformance with the rules of the Michigan Board of Land Surveyors or by a Decree of a Court of Law; established, re-established, monumented, recovered, found as expressed below:

NOTE: Not more than 2 corners, all in the same town and range, may be recorded on this certificate.

	A	B	C	D	E	F	G	H	I	J	K	L	M
1													
2		6		5		4		3		2		1	
3													
4		7		8		9		10		11		12	
5													
6		18		17		16		15		14		13	
7													
8		19		20		21		22		23		24	
9													
10		30		29		28		27		26		25	
11													
12		31		32		33		34		35		36	
13													

A. Description of original monument and accessories and/or subsequent restoration:
M-10: E. 1/4 Cor. Sec. 25, T26N-R8W, Boardman Township
1852, GLO resurvey, set post, 6" Beech N18W, 16, 8" Beech S10W, 28
04-27-1901, W.S. Merrill, Co. Surveyor, set pine stake, w/accessories
11-17-1981, N.B. DeYoung #20705, Cert. Survey, fd. 1/2" iron, w/accessories
05-28-1987, Farrier Surveying, LCR, fd. 1/2" iron rod, w/accessories, Lib. 2, Pg. 323
05-30-1987, Farrier Surveying, Cert. Survey, Fd. 1/2" iron rod, w/accessories

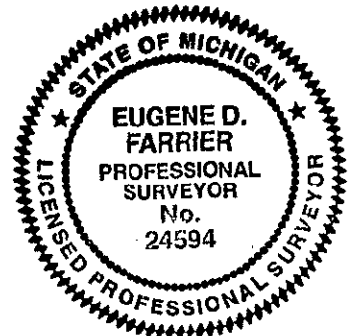

B. Description of corner evidence found and/or method applied in restoring or reestablishing corner:
M-10: E. 1/4 Cor. Sec. 25, T26N-R8W, Boardman Township
Fd. 1/2" x 18" iron in West edge of Puffer Rd. Pulled & replaced with 5/8" x 18" rebar, w/brass cap in mon. box. No GLO witnesses were fd. The Kalkaska Co. Peer group approved the above monument as the best available evidence of the position of the original corner.

C. Description of monument for corner and accessories established to perpetuate locating the position of the corner:
M-10: E. 1/4 Cor. Sec. 25, T26N-R8W, Boardman Township
Fd. 1/2" x 18" iron in West edge of Puffer Rd. Pulled & replaced with 5/8" x 18" rebar, w/brass cap in mon. box.
Fd. S84W, conc. Mon., 32.87'
Fd. N83E, conc. Mon., 44.90'
Fd. S18E, conc. Mon., 90.71'
Fd. S06W, Standard Co. Mon., 164.21' (Closing corner)

Ratified by Peer Group
P.A. 345 - 1990 Kalkaska County
Chairman Eugene Farrier
Date 1-29-98

Signed by Eugene Farrier
Surveyor's Michigan License No. 24594

Date 2-3-98



3004885
Page: 1 of 1
02/04/98 11:22