

MICHIGAN
DEPARTMENT OF CONSERVATION
FORESTRY DIVISION

LAND CORNER RECORD

T. 26 N.R. 8 W


Kalkaska COUNTY

DESCRIPTION OF CORNER 1/4 corner common to sections 8-17

CORNER MONUMENT Set Cons. Dept. Mon.

DATE MONUMENT PLACED AND WITNESSED 8/28/67

WITNESSES TO CORNER.....

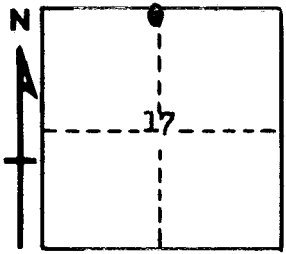

CIRCLE CORNER REGISTERED

7" W. Pine S 52 E 17.5'


14" W. Pine S 17 W 43.1'

AND

DESCRIPTION IN DETAIL AS TO HOW CORNER WAS LOCATED AND IDENTIFIED OR RESTORED.

This corner was set by proportionate measurement between restored section corners. Could not locate anything for previous corner, after search at two possible U.S. locations.

Fits swamp edge and stream acceptably.

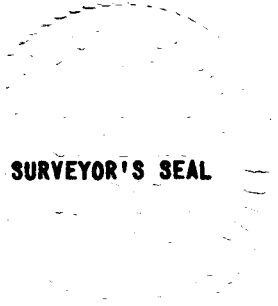

SURVEYOR'S SEAL

SIGNED *Kenneth J. Ostling* DATE 9/20/67
REGISTERED LAND SURVEYOR #10068