

MICHIGAN
DEPARTMENT OF CONSERVATION
FORESTRY DIVISION

LAND CORNER RECORD


T. 27 N.R. 4 W
T. 27 N.R. 5 W Crawford-Kalkaska COUNTY

DESCRIPTION OF CORNER 1/4 corner common to Sections 13 and 18

CORNER MONUMENT Set 1" pipe with 4" aluminum cap

DATE MONUMENT PLACED AND WITNESSED October 6, 1965

WITNESSES TO CORNER.....

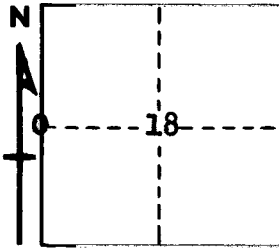

CIRCLE CORNER REGISTERED

6" R. Pine N 46 W 8.5'


5" R. Pine S 9 W 2.8'

AND

DESCRIPTION IN DETAIL AS TO HOW CORNER WAS LOCATED AND IDENTIFIED OR RESTORED.

This corner was set by proportionate measurement, midpoint on line, between section corners.

SURVEYOR'S SEAL

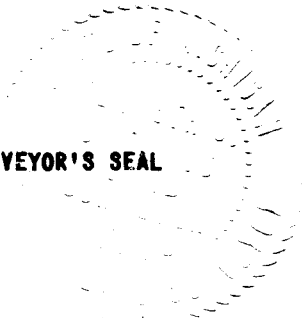

SIGNED Kenneth J. Ostling DATE October 18, 1965
REGISTERED LAND SURVEYOR #10668