LAND CORNER RECORDATION CERTIFICATE

Filing Requirement of Act 74, Mich. P.A. 1970

For corners in KALKASKA (County)

	Located In:	Corner Code ##
1. Public Land Survey	T 27N R 5W	E-4,G-4
	T ___ R ___	
	T ___ R ___	
	T ___ R ___	
2. Property Controlling	S 9 T ___ R ___	8
in Section	S ___ T ___ R ___	
3. Miscellaneous	S ___ T ___ R ___	
Property in Sec.	S ___ T ___ R ___	

Register of Deeds Stamp & File Number

4. Lot No. _____ , Recorded Plat _____
5. Private Claims _____

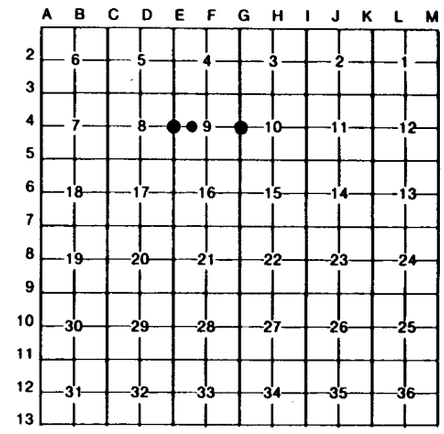

I, CARL KIISKILA , in a field survey on AUG. 9 , 19 95 , do hereby certify that under requirements of P.A. 74, Michigan P.A. of 1970, the corner points mentioned in lines 1 and 2 above were in conformance with regulations and rules therefore as required in the current manual of survey instructions of the United States Department of the Interior, Bureau of Land Management or by a decree of a Court of Law and/or that the corner points mentioned in lines 3, 4 and 5 above were in conformance with the rules of the Michigan Board of Land Surveyors or by a Decree of a Court of Law; established, re-established, monumented, re-monumented, recovered, found as expressed below:

NOTE: Not more than 4 corners, all in the same town and range, may be recorded on this certificate.

A. Description of original monument and accessories and/or subsequent restoration:

E-4 G-4 8

(NO EVIDENCE OF G.L.O. CORNER, B.T'S, LINE TREES & TOPOGRAPHY, AS CALLED OUT IN THE G.L.O. LINE NOTES; UNLESS NOTED IN ITEM "B" BELOW.)

B. Description of corner evidence found and/or method applied in restoring or reestablishing corner:

E-4	G-4	8
REESTABLISHED THE W 1/4 COR OF SEC 9 BY SINGLE PROPORTIONATE MEASUREMENT BETWEEN FOUND CORNERS 1/2 MILE TO THE NORTH AND SOUTH.	FD AND ACCEPTED 1 1/4" PIPE, 24" ABOVE GROUND, SET BY M. SCHAAF FOR THE E 1/4 COR OF SECTION 9. M. SCHAAF'S NOTES STATES HE PERPETUATED THIS CORNER FROM BOTH U.S.B.T. SITES.	ESTABLISHED THE SW CORNER OF THE SE 1/4 OF THE NE 1/4 OF SEC 9 PER STANDARD BLM INSTRUCTIONS FOR SUB'D OF A SECTION.

C. Description of monument for corner and accessories established to perpetuate locating the position of the corner:

E-4			G-4			8		
SET DNR MON, 1" PIPE WITH 4" AL CAP, AND CARSONITE POST.			FOUND 1 1/4" IRON PIPE.			SET CAPPED 5/8" X 32" REROD AND CARSONITE POST.		
8" BEECH	S11°E	6.71'	7" W. PINE	S21°E	17.93'	10" MAPLE	S38°E	8.62'
9" TWN MAPLE	N74°W	24.15'	4" MAPLE	S46°W	11.58'	10" MAPLE	S39°W	20.30'
8" QUAD MAPLE	N14°E	23.12'	6" R. PINE	N51°W	12.73'	10" MAPLE	N47°W	11.15'
5" CLMP BEECH	S87°E	17.09'	5" W. PINE	N47°E	14.34'	8" MAPLE	N50°E	22.25'

STATE OF MICHIGAN
CARL KIISKILA
LAND SURVEYOR
No. 33981
LICENSED LAND SURVEYOR

Signed by Carl T. Kiiskila 33981 Date 10-2-95

Surveyor's Michigan License No. _____

FORM APPROVED BY MICHIGAN STATE BOARD OF LAND SURVEYORS, JAN. 28, 1971
REVISED MAY 14, 1975
REVISED JAN., 1983