LAND CORNER RECORDATION CERTIFICATE

Filing Requirement of Act 74, Mich. P.A. 1970

For corners in KALKASKA (County)

	Located In:	Corner Code ##
1. Public Land Survey	T 27N R 5W	G-5,F-5
	T ___ R ___	
	T ___ R ___	
	T ___ R ___	
2. Property Controlling	S 9 T ___ R ___	13,16
in Section	S ___ T ___ R ___	
3. Miscellaneous	S ___ T ___ R ___	
Property in Sec.	S ___ T ___ R ___	

Register of Deeds Stamp & File Number

4. Lot No. _____ , Recorded Plat _____
5. Private Claims _____

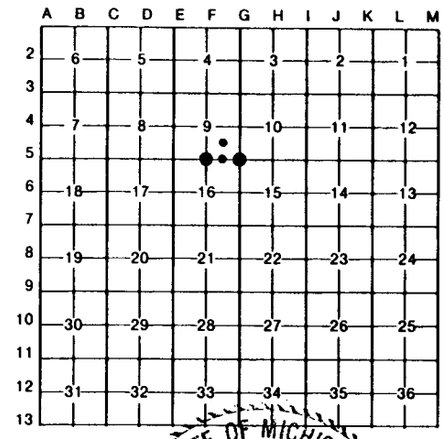

I, CARL KIISKILA, in a field survey on AUGUST 16, 19 95, do hereby certify that under requirements of P.A. 74, Michigan P.A. of 1970, the corner points mentioned in lines 1 and 2 above were in conformance with regulations and rules therefore as required in the current manual of survey instructions of the United States Department of the Interior, Bureau of Land Management or by a decree of a Court of Law and/or that the corner points mentioned in lines 3, 4 and 5 above were in conformance with the rules of the Michigan Board of Land Surveyors or by a Decree of a Court of Law; established, re-established, monumented, re-monumented, recovered, found as expressed below:

NOTE: Not more than 4 corners, all in the same town and range, may be recorded on this certificate.

STATE OF MICHIGAN
CARL KIISKILA
LAND SURVEYOR
No. 33981
LICENSED LAND SURVEYOR

A. Description of original monument and accessories and/or subsequent restoration:

G-5 F-5 13

(NO EVIDENCE OF G.L.O. CORNER, B.T'S, LINE TREES & TOPOGRAPHY, AS CALLED OUT IN THE G.L.O. LINE NOTES; UNLESS NOTED IN ITEM "B" BELOW.)

B. Description of corner evidence found and/or method applied in restoring or reestablishing corner:

G-5	F-5	13	16
RECOVERED STD DNR MONUMENT FITTING RLS CARL ROSER JUNE 19, 1980 WITNESSES AND L.C.R.C. CORNER WAS PREVIOUSLY SET BY M. SCHAAF FROM U.S. EVIDENCE.	FD. AND ACCEPTED 1 1/4"x 24" PIPE BY M.SCHAAF FOR THE S1/4 COR OF SECTION 9. M.SCHAAF NOTES STATES HE PERPETUATED THIS CORNER FROM FOUND BOTH U.S.B.T. SITES.	ESTABLISHED THE NW CORNER OF THE SE1/4 OF THE SE1/4 OF SEC. 9 PER STANDARD BLM INSTRUCTIONS FOR THE SUB'D. OF A SECTION. NORTH END OF N-S TRAIL ROAD IS 10' SOUTH.	ESTABLISHED THE SW CORNER OF THE SE1/4 OF THE SE1/4 OF SECTION 9 PER STANDARD BLM INSTRUCTIONS. FD. NICHOLAS DeYOUNG'S (P.S. #19830) 1/2" REROD (AS SET IN ERROR) S48°E, 10.95'.

C. Description of monument for corner and accessories established to perpetuate locating the position of the corner:

G-5			F-5			13			16		
FOUND DNR MON & 1 1/2" IRON PIPE. SET CARSONITE POST.			FD 1 1/4"x 24" PIPE, SET CARSONITE POST.			SET 5/8"x 32" CAPPED REROD AND CARSONITE POST.			SET CAPPED 5/8"x 32" REROD AND CARSONITE POST.		
#10" MAPLE	N82°E	9.16'	3" W.PINE	N60°W	3.33'	11" W.PINE	N85°E	13.60'	14" W.PINE	N26°W	16.72'
#12" MAPLE	S37°W	9.84'	12" W.PINE	S07°W	7.30'	10" W.PINE	S42°W	3.84'	8" W.PINE	N44°E	11.17'
#12" MAPLE	N79°W	19.15'	4" W.PINE	S73°E	19.73'	6" R.PINE	N32°W	25.66'	6" W.PINE	S12°E	1.89'
8" MAPLE	NORTH	17.56'	3" W.PINE	N58°E	20.69'	8" W.PINE	S24°E	40.51'	4" W.PINE	S65°W	21.52'
						46' W.PINE	N17°W	37.79'			

#1980 D.N.R. Wit.

Signed by Carl T Kiiskila Date 10-2-95

Surveyor's Michigan License No. 33981

FORM APPROVED BY MICHIGAN STATE BOARD OF LAND SURVEYORS, JAN. 28, 1971
REVISED MAY 14, 1975
REVISED JAN., 1983