LAND CORNER RECORDATION CERTIFICATE

Filing Requirement of Act 74, Mich. P.A. 1970

For corners in KALKASKA (County)

	Located In:	Corner Code ##
1. Public Land Survey	T 27N R 5W	E-3,F-3,G-3
	T ___ R ___	
	T ___ R ___	
	T ___ R ___	
2. Property Controlling	S 9 T ___ R ___	1
in Section	S ___ T ___ R ___	
3. Miscellaneous	S ___ T ___ R ___	
Property in Sec.	S ___ T ___ R ___	

Register of Deeds Stamp & File Number

4. Lot No. _____ , Recorded Plat _____
5. Private Claims _____

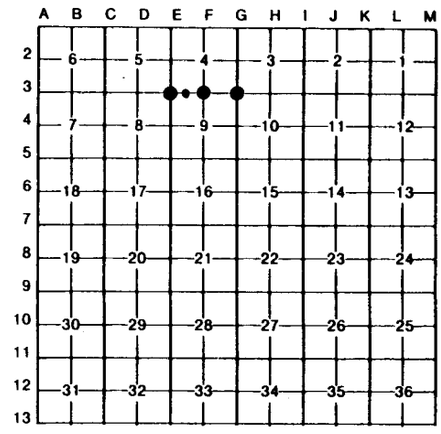

I, CARL KIISKILA, in a field survey on AUGUST 9, 19 95, do hereby certify that under requirements of P.A. 74, Michigan P.A. of 1970, the corner points mentioned in lines 1 and 2 above were in conformance with regulations and rules therefore as required in the current manual of survey instructions of the United States Department of the Interior, Bureau of Land Management or by a decree of a Court of Law and/or that the corner points mentioned in lines 3, 4 and 5 above were in conformance with the rules of the Michigan Board of Land Surveyors or by a Decree of a Court of Law; established, re-established, monumented, re-monumented, recovered, found as expressed below:

NOTE: Not more than 4 corners, all in the same town and range, may be recorded on this certificate.

A. Description of original monument and accessories and/or subsequent restoration:

E-3 F-3 G-3 1

(NO EVIDENCE OF G.L.O. CORNER, B.T'S, LINE TREES & TOPOGRAPHY, AS CALLED OUT IN THE G.L.O. LINE NOTES; UNLESS NOTED IN ITEM "B" BELOW.)

STATE OF MICHIGAN
CARL KIISKILA
LAND SURVEYOR
No. 33981
LICENSED LAND SURVEYOR

B. Description of corner evidence found and/or method applied in restoring or reestablishing corner:

E-3
FOUND DNR MONUMENT FOR THE NW COR OF SEC 9. CORNER WAS SET FROM FD M. SCHAAF WITS BY RLS J. FLETCHER (#19830) AND REMONUMENTED IN PREVIOUS DNR SURVEY BY P.S, C.F.ROSER (#12028) IN 1978.

F-3
FD 1/2" IRON ROD FOR THE N 1/4 COR OF SECTION 9. CORNER WAS SET FROM FD M. SCHAAF WITS BY RLS J. FLETCHER (#19830). CTR OF E-W TRAIL RD IS 80' NORTH AND CTR OF N-S TRAIL RD IS 23' EAST.

G-3
FOUND DNR MONUMENT FOR THE NE COR OF SEC 9. CORNER WAS WITNESSED BY M. SCHAAF FROM U.S.B.T. RLS J. FLETCHER (#19830) SET A 1/2" REROD FROM M. SCHAAF WITS. A DNR SURVEY CREW REPLACED A 1/2" X 24" REROD WITH A DNR MONUMENT DURING A AUGUST 1977 SURVEY.

1
ESTABLISHED THE NW CORNER OF THE NE 1/4 OF THE NW 1/4 OF SEC 9 PER STANDARD BLM INSTRUCTIONS. FD A 1/2" CAPPED REROD, WITH NO P.S. NUMBER, 32.65' EAST.

C. Description of monument for corner and accessories established to perpetuate locating the position of the corner:

E-3
FOUND DNR MON & CEDAR POST.

*14" CHERRY	S07°E	35.54'
*7" CHERRY	N42°W	24.21'
*8" MAPLE	N30°E	31.10'
*6" MAPLE	S81°E	13.72'

* 1978 DNR WIT.

F-3
CEDAR POST IN PLACE. SET DNR MON OVER EXISTING 1/2" IRON.

16" CHERRY	S09°W	18.08'
8" MAPLE	N84°W	38.81'
6" CHERRY	S53°E	70.02'
CEDAR POST	N05°E	1.55'

G-3
FOUND DNR MON & CEDAR POST.

4" MAPLE	S55°W	19.71'
3" MAPLE	NORTH	12.41'
*16" MAPLE	N57°E	26.61'
6" MAPLE	S26°E	30.40'

*OLD WITNESS BY OTHERS.

1
SET 1"x 48" IRON PIPE W/PS CAP & CARSONITE POST.

SE CORNER METAL GARAGE	N16°E	27.84'
SW CORNER METAL GARAGE	N32°W	51.16'
5" CHERRY	S74°E	10.09'
8" CHERRY	S21°E	5.91'

Signed by Carl T. Kiiskila Date 10-2-95

Surveyor's Michigan License No. 33981

FORM APPROVED BY MICHIGAN STATE BOARD OF LAND SURVEYORS, JAN. 28, 1971
REVISED MAY 14, 1975
REVISED JAN., 1983