LAND CORNER RECORDATION CERTIFICATE

Filing Requirement of Act 74, Mich. P.A. 1970

For corners in KALKASKA (County)

	Located In:	Corner Code #
1. Public Land Survey	T 27N R 5W	E-5
	T ___ R ___	
	T ___ R ___	
	T ___ R ___	
2. Property Controlling	S 9 T ___ R ___	10,12
in Section	S ___ T ___ R ___	
3. Miscellaneous	S ___ T ___ R ___	
Property in Sec.	S ___ T ___ R ___	

Register of Deeds Stamp & File Number

4. Lot No. _____ , Recorded Plat _____
5. Private Claims _____

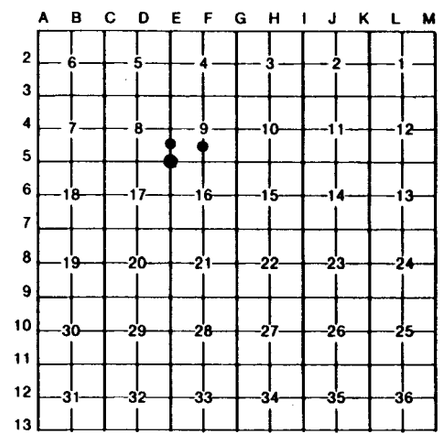

I, CARL KIISKILA, in a field survey on AUG. 9, 19 95, do hereby certify that under requirements of P.A. 74, Michigan P.A. of 1970, the corner points mentioned in lines 1 and 2 above were in conformance with regulations and rules therefore as required in the current manual of survey instructions of the United States Department of the Interior, Bureau of Land Management or by a decree of a Court of Law and/or that the corner points mentioned in lines 3, 4 and 5 above were in conformance with the rules of the Michigan Board of Land Surveyors or by a Decree of a Court of Law; established, re-established, monumented, re-monumented, recovered, found as expressed below:

NOTE: Not more than 4 corners, all in the same town and range, may be recorded on this certificate.

A. Description of original monument and accessories and/or subsequent restoration:

E-5 10 12

(NO EVIDENCE OF G.L.O. CORNER, B.T'S, LINE TREES & TOPOGRAPHY, AS CALLED OUT IN THE G.L.O. LINE NOTES; UNLESS NOTED IN ITEM "B" BELOW.)

B. Description of corner evidence found and/or method applied in restoring or reestablishing corner:

E-5

FD AND ACCEPTED A 4" CONC MONUMENT WITH 1/2" BAR FOR THE SW CORNER OF SEC 9. THE MONUMENT WAS PREVIOUSLY USED BY SURVEYORS FOR SURVEYS IN SECTION 17 AND BY RLS NICHOLAS B. DEYOUNG FOR SURVEY IN SECTION 9.

10

FOUND THE SW CORNER OF THE NW 1/4 OF THE SE 1/4 OF SECTION 9 SET BY NICHOLAS DEYOUNG PER STD INSTRUCTIONS FOR SUB'D OF A SECTION. CTR OF TURNAROUND AT WEST END OF TRAIL FROM EAST IS S30°E 30'+/-.

12

ESTABLISHED THE SW CORNER OF THE NW 1/4 OF THE SE 1/4 OF SEC 9 PER STANDARD BLM INSTRUCTIONS FOR SUB'D OF A SECTION.

C. Description of monument for corner and accessories established to perpetuate locating the position of the corner:

E-5

FOUND CONC MON.

9" R. PINE	N88°E	11.74'
5" R. PINE	S04°W	13.24'
8" MAPLE	N60°W	16.51'
6" R. PINE	N20°E	12.20'

10

FOUND 1/2" IRON ROD.

*5" MAPLE	N03°W	5.07'
5" W. PINE	N88°W	8.69'
5" MAPLE	S13°E	4.43'
5" W. PINE	S73°E	27.17'

*OLD WITNESS BY OTHERS

12

SET 5/8" X 32" REROD W/CAP & CARSONITE POST.

16" R. PINE	N11°E	21.83'
6" R. PINE	S85°E	8.26'
6" R. PINE	S08°E	3.81'
8" R. PINE	N87°W	14.16'

STATE OF MICHIGAN
CARL KIISKILA
LAND SURVEYOR
No. 33981
LICENSED LAND SURVEYOR

Signed by Carl T Kiiskila Date 10-2-95

Surveyor's Michigan License No. 33981

FORM APPROVED BY MICHIGAN STATE BOARD OF LAND SURVEYORS, JAN. 28, 1971
REVISED MAY 14, 1975
REVISED JAN., 1983