

# LAND CORNER RECORDATION CERTIFICATE

## FILING REQUIREMENT OF ACT 74, MICH. P.A.1970

FOR CORNERS OF--:	LOCATED IN--:	CORNER CODE NUMBER
1. PUBLIC LAND SURVEY _____	T. <u>27</u> N. <u>5</u> W.	<u>E-1; E-3; F-1; H-1</u>
2. PROPERTY CONTROLLING IN SECTION _____	T. _____ N. _____ S. _____ R. _____ W. _____	_____
3. MISCELLANEOUS PROPERTY IN SECTION _____	T. _____ N. _____ S. _____ R. _____ W. _____	_____
4. LOT NO. _____, RECORDED PLAT _____		
5. PRIVATE CLAIMS _____		

REGISTER OF DEEDS STAMP AND FILING NUMBER

I, Carl F. Roser, do hereby certify that under requirements of P.A. 74, Michigan P.A. of 1970, the corner points mentioned in lines 1 and 2 above were, in a field survey on Aug. 11, 1977, established, re-established, monumented, re-monumented, recovered or restored as expressed below and in conformance with regulations and rules therefore as required in the current manual of survey instructions of the United States Department of the Interior, Bureau of Land Management or by a decree of a court of law. Furthermore, that the corner points mentioned in lines 3, 4 and 5 above were, in a field survey on \_\_\_\_\_, 19\_\_\_\_, found, recovered, restored, established or re-established as expressed below and in conformance with the rules of the Michigan State Board of Registration for Land Surveyors or, by a Decree of a Court of law:

~~A. Description of original monument and accessories and for subsequent restoration:~~

C. (continued)

H-1  
Drove 1 1/4" X 18" Iron Pin at N. edge of E-W B.Top Rd.  
11" Maple N55°E 24.60  
14" Maple S47°W 65.57  
5" Maple S44°E 80.17  
Set ced. post w/Loc. Tag  
Due S 44'  
P.Pole N58°W 77.47

B. Description of corner evidence found and/or method applied in restoring or re-establishing corner:


- E-1 Recovered B.Spk as fd. & accepted by R.L.S.; J. Fletcher (#19830). The B.Spk. fits position per W.S. Merrill survey of 1915 & 1922 and also as noted in W.P.A. notes for Co. Rd. 612 (1936+).
- E-3 Recovered 1/2" rod by R.L.S., J.Fletcher (#19830), said re-rod being set from fd.Schaaf Wit
- F-1 Recovered 1/2" rod which was estab. by R.L.S., J.Fletcher equidistant & on line btw. fd. Sec. Cor's. to E & W in his survey of Sec. 4 (T27N-R5W).
- H-1 Re-estab. 1/4 cor. equidistant & on line btw. fd. Sec. Cor's. to E & W. Fn N 1/y is 2'+E & is approx. position only, per talk w/land owner R.Brown who built fn. in 1940. Cor. falls 11'+ N. of Ctr. of E-W b.top rd. (Co. Rd. 612).

C. Description of monument for corner and accessories established to perpetuate locating the position of the corner:

	E-1	E-3	F-1
Fd. B.Spk; Replaced w/ 1 1/4"X18" Iron Rod		Fd. 1/2" pipe & added DNR Mon. & ced. post	Fd. 1/2" Rod w/RLS cap #19830 in approx. Ctr. of E-W B.Top Rd
9" Maple	S51°W 50.8	7" Maple N21°E 30.9	12" B.Cherry N04°W 110.72
8" Maple	S42°E 48.2	8" B.Cherry N44°W 23.9	16" B.Cherry S22°E 63.98
Fd.Schaaf pipe	S14°57'W 71.68	10" Maple S11°E 35.2	14" Elm S38°W 56.65
Ctr. E-W B.Top Rd		6" Maple S87°E 13.6	Set ced.post w/Loc. tag
Set ced.post	Due N 1'+ Due S 33'+		Due S 33'

SIGNED BY Carl F. Roser DATE 3-31-78

SURVEYOR'S MICHIGAN REGISTRATION NO. 12028

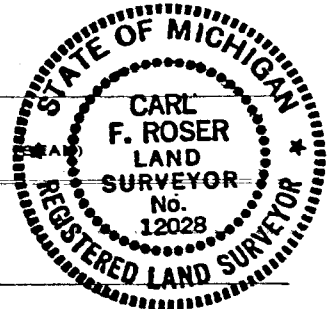

FOR STATE AND UNITED STATES AGENCIES:

SIGNED BY \_\_\_\_\_ DATE \_\_\_\_\_  
CHIEF OF SURVEY PARTY

APPROVED AND SIGNED BY \_\_\_\_\_ DATE \_\_\_\_\_  
MICHIGAN REGISTERED LAND SURVEYOR (SEAL)

SURVEYOR'S MICHIGAN REGISTRATION NO. \_\_\_\_\_ BEAR LAKE TOWNSHIP  
KALKASKA COUNTY

MAY PLACE SKETCH ON BACK OR ATTACHED SHEET