

LAND CORNER RECORDATION CERTIFICATE

FILING REQUIREMENT OF ACT 74, MICH. P.A.1970

FOR CORNERS OF--:	LOCATED IN--:	CORNER CODE NUMBER
1. PUBLIC LAND SURVEY _____	T. <u>27</u> N. <u>●</u> R. <u>5</u> W. <u>●</u>	<u>E-8; E-9; G-8; G-9</u>
2. PROPERTY CONTROLLING IN SECTION _____	, T. _____ N. _____ S. _____ R. _____ E. _____ W. _____	_____
3. MISCELLANEOUS PROPERTY IN SECTION _____	, T. _____ N. _____ S. _____ R. _____ E. _____ W. _____	_____
4. LOT NO. _____	RECORDED PLAT _____	
5. PRIVATE CLAIMS _____		

REGISTER OF DEEDS STAMP AND
FILING NUMBER _____

I, Carl F. Roser, do hereby certify that under requirements of P.A. 74, Michigan P.A. of 1970, the corner points mentioned in lines 1 and 2 above were, in a field survey on March 25, 1976, established, re-established, monumented, re-monumented, recovered or restored as expressed below and in conformance with regulations and rules therefore as required in the current manual of survey instructions of the United States Department of the Interior, Bureau of Land Management or by a decree of a court of law. Furthermore, that the corner points mentioned in lines 3, 4 and 5 above were, in a field survey on _____, 19____, found, recovered, restored, established or re-established as expressed below and in conformance with the rules of the Michigan State Board of Registration for Land Surveyors or, by a Decree of a Court of law:

~~A = Description of original monument and accessories and/or subsequent restoration~~

C. (continued)

G-9

DNR Monument & Cedar Post
 7" W. Pine N59°W 94.7
 7" W. Pine S44°W 125.1
 8" R. Pine S47°E 50.9
 9" W. Pine N79°E 108.6

B. Description of corner evidence found and/or method applied in restoring or re-establishing corner:

- E-8 Found concrete monument per "Supervisors Carroll Hendricks Plat of Pine Acres".
- E-9 Recovered previous dept. corner of record which was a perpetuation of Schaaf corner set from remains of U.S.B.T.'s. Corner is in center of N-S dirt co.rd, trail rd. to E is approximately 100' to N.
- G-8 Reestablished ¼ corner equidistant & on line between fd. sec. corners to N & S. Fd. Schaaf stake & wits. but did not accept, since Schaaf's stake was 39.3' E of where his line notes say he set the corner.
- G-9 Recovered Schaaf stake and three of his witnesses.

C. Description of monument for corner and accessories established to perpetuate locating the position of the corner:

E-8	E-9	G-8
4" Rd. conc. mon. w/½" rerod & cedar post w/loc. tag	DNR Monument	Set DNR monument-cedar post
Power Pole N62°W 36.00	Power Pole N65°W 35.67	8" J. Pine N36°E 105.8
6" R. Pine S06°E 12.8	5" R. Pine S35°E 66.4	30" W. Pine Stp. N05°W 77.5
6" R. Pine N48°E 44.1	6" W. Pine N66°E 56.8	26" W. Pine Stp. S46°W 24.8
Conc. Mon. Due W 33.0	Set cedar post w/loc. tag	24" W. Pine Stp. S36°E 38.1
Center N-S Co. road	Due E 33.0	24" Y. Pine Stp. S75°E 61.0
Due E 109'±		

SIGNED BY Carl F. Roser 4-28-77 DATE _____

SURVEYOR'S MICHIGAN REGISTRATION NO. 12028


FOR STATE AND UNITED STATES AGENCIES:

SIGNED BY _____ DATE _____

CHIEF OF SURVEY PARTY

APPROVED AND SIGNED BY _____ DATE _____

MICHIGAN REGISTERED LAND SURVEYOR

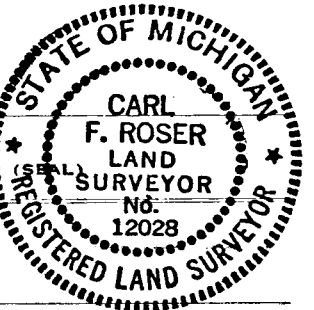

(SEAL)

SURVEYOR'S MICHIGAN REGISTRATION NO. _____ BEAR LAKE TOWNSHIP
KALKASKA COUNTY