

**SURVEY & REMONUMENTATION**

KALKASKA COUNTY, MICHIGAN RECEIVED

MAY 10 1999

LAND CORNER RECORDATION CERTIFICATE 1994 DEC 23 AM 9:12  
Filing Requirement of Act 74, Mich. P.A. 1970

For corners in

**SECTION**

KALKASKA (County)  
1994 REMONUMENTATION

Located In:

Corner Code ##

*Jean Hall*  
REG. OF DEEDS

Register of Deeds Stamp & File Number

- 1. Public Land Survey T 27N R 6W B-7
- T \_\_\_\_\_ R \_\_\_\_\_
- T \_\_\_\_\_ R \_\_\_\_\_
- T \_\_\_\_\_ R \_\_\_\_\_
- 2. Property Controlling S \_\_\_\_\_ T \_\_\_\_\_ R \_\_\_\_\_
- In Section S \_\_\_\_\_ T \_\_\_\_\_ R \_\_\_\_\_
- 3. Miscellaneous S \_\_\_\_\_ T \_\_\_\_\_ R \_\_\_\_\_
- Property in Sec. S \_\_\_\_\_ T \_\_\_\_\_ R \_\_\_\_\_

- 4. Lot No. \_\_\_\_\_, Recorded Plat \_\_\_\_\_
- 5. Private Claims \_\_\_\_\_

	A	B	C	D	E	F	G	H	I	J	K	L	M
2	6	5	4	3	2	1							
3													
4	7	8	9	10	11	12							
5													
6	18	17	16	15	14	13							
7	●												
8	19	20	21	22	23	24							
9													
10	30	29	28	27	26	25							
11													
12	31	32	33	34	35	36							
13													

I, EUGENE FARRIER, in a field survey on NOV. 12, 1994, do hereby certify that under requirements of P.A. 74, Michigan P.A. of 1970, the corner points mentioned in lines 1 and 2 above were in conformance with regulations and rules therefore as required in the current manual of survey instructions of the United States Department of the Interior, Bureau of Land Management or by a decree of a Court of Law and/or that the corner points mentioned in lines 3, 4 and 5 above were in conformance with the rules of the Michigan Board of Land Surveyors or by a Decree of a Court of Law; established, re-established, monumented, re-monumented, recovered, found as expressed below:

**NOTE: Not more than 4 corners, all in the same town and range, may be recorded on this certificate.**

A. Description of original monument and accessories and/or subsequent restoration:

B-7: Cor. common to Sec. 18 & 19, T27N-R6W  
1850 GLO re-survey: set post, Beech 14", N45E, 40, Beech 14", S28W, 24  
7-6-1889, E. Mosher, noted cor., no accessories  
4-20-1895, E.B. Dennis, noted cor., w/accessories  
5-6-01 & 4-4-11, W.S. Merrill, noted cor., no accessories  
4-74 to 8-93, Certificates of Survey, all fd Con. Mon., D.E. Porter (Lib 1 Pg's 536, 772, 538, 771, 537, 773, 539, Plat of Sugar Bush),  
E. Farrier( fd cor. w/accessories)


B. Description of corner evidence found and/or method applied in restoring or reestablishing corner:

B-7: Cor. common to Sec. 18 & 19, T27N-R6W  
Fd con. mon., added alu. cap at ground level. No GLO witnesses were fd.  
On 12-20-94 the Kalkaska Co. peer group approved the above monument as a careful and faithful reestablishment of the position of the original corner.

Ratified by Peer Group  
P.A. 345 - 1990 Kalkaska County  
Chairman *Eugene Farrier*  
Date 12-20-94

C. Description of monument for corner and accessories established to perpetuate locating the position of the corner:

B-7: Cor. common to Sec. 18 & 19, T27N-R6W  
Fd con. mon., added alu. cap at ground level.  
Fd iron & cap (Porter) S60W, 86.44'  
Fd con-mon. S48W, 92.82'  
Fd SW cor. gray hse, N70E, 72.30'  
Fd NW cor. gray hse, N28E, 92.05'

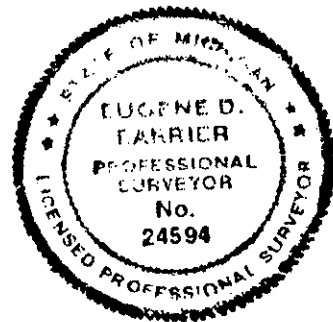

Signed by *Eugene Farrier*  
Surveyor's Michigan License No. 24594

Date 12-22-94