

SURVEY & REMONUMENTATION

KALKASKA COUNTY, MICHIGAN
RECEIVED

MAY 10 1999

LAND CORNER RECORDATION CERTIFICATE 1994 DEC 23 AM 9:12
Filing Requirement of Act 74, Mich. P.A. 1970

Jean Hall
REG. OF DEEDS

corners in	SECTION	Located In:	Corner Code #
KALKASKA			
(County)			
1994 REMONUMENTATION			
Public Land Survey	T 27N R 6W	B-9	
	T _____ R _____		
	T _____ R _____		
	T _____ R _____		
Property Controlling	S _____ T _____ R _____		
in Section	S _____ T _____ R _____		
Miscellaneous	S _____ T _____ R _____		
Property in Sec.	S _____ T _____ R _____		

Register of Deeds Stamp & File Number

Lot No. _____, Recorded Plat _____
Private Claims _____

	A	B	C	D	E	F	G	H	I	J	K	L	M
2	6	5	4	3	2	1							
3													
4	7	8	9	10	11	12							
5													
6	10	17	16	15	14	13							
7													
8	19	20	21	22	23	24							
9	●												
10	30	29	28	27	26	25							
11													
12	31	32	33	34	35	36							
13													

EUGENE FARRIER, in a field survey on NOV. 12, 1994, hereby certify that under requirements of P.A. 74, Michigan P.A. of 1970, the corner points mentioned in lines 1 and 2 above were in conformance with regulations and rules therefore as required in the recent manual of survey instructions of the United States Department of the Interior, Bureau of Land Management or by a decree of a Court of Law and/or that the corner points mentioned in lines 3, 4 and 5 above were in conformance with the rules of the Michigan Board of Land Surveyors or by a Decree of a Court of Law; established, re-established, monumented, re-monumented, recovered, found as pressed below:

NOTE: Not more than 4 corners, all in the same town and range, may be recorded on this certificate.

Description of original monument and accessories and/or subsequent restoration:

B-9: Cor. common to Sec. 19 & 30, T27N-R6W
1850 GLO re-survey: set post, Hemlock 12", S65E, 17, Tamrk 12", N72W, 19 12-26-02, W.S. Merrill, noted cor., w/accessories
1937, MDOT, noted cor., no accessories, (Right-of-way map)
5-23-74, LCRC(D.E. Porter), fd pk nail 1.5' S. of rd C/L, w/access, Lib 1 Pg 317
9-9-77, N.F. Parker, fd cor, w/access, Lib 2 Pg's 83 & 84
11-11-80, J.L.Fletcher, fd pk nail 1.5' S of C/L, w/access, Lib 2 Pg 599
2-93, Wilcox Assoc., fd pk nail of rec. 1.7' S. of C.L. M-72, w/access.


Description of corner evidence found and/or method applied in restoring or reestablishing corner:

B-9: Cor. common to Sec. 19 & 30, T27N-R6W
Fd PK nail of record 1.7' South of C/L M-72. Pulled & set 5/8" x 18" R.B. w/brass cap 0.4' below surface in Mon. box. No GLO wit. fd.
On 12-20-94 the Kalkaska Co. peer group approved the above monument as a careful and faithful reestablishment of the position of the original corner.

Ratified by Peer Group
P.A. 345 - 1990 Kalkaska County
Chairman *Eugene Farrier*
Date 12-20-94

Description of monument for corner and accessories established to perpetuate locating the position of the corner:

B-9: Cor. common to Sec. 19 & 30, T27N-R6W
Fd PK nail of record 1.7' South of C/L M-72. Pulled & set 5/8" x 18" R.B. w/brass cap 0.4' below surface in Mon. box.
S08E, 49.92', fd nail Power Pole.
S43E, 103.20', set nail & tag in 16" Scotch Pine.
N02W, 75.40', fd nail 10" W. Pine
N45E, 66.10', fd nail 14" Jack Pine.

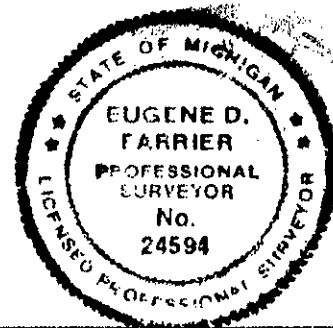

ed, by *Eugene Farrier*
Surveyor's Michigan License No. 24594

Date 12-22-94