

SURVEY & REMONUMENTATION

MAY 10 1999

KALKASKA COUNTY, MICHIGAN RECEIVED

LAND CORNER RECORDATION CERTIFICATE 1994 DEC 23 AM 9:14
Filing Requirement of Act 74, Mich. P.A. 1970

corners in SECTION

ALASKA (County)	Located In:	Corner Code #
1994 REMONUMENTATION	T 27N R 6W	B-11
Public Land Survey	T _____ R _____	_____
	T _____ R _____	_____
	T _____ R _____	_____
Property Controlling in Section	S _____ T _____ R _____	_____
Miscellaneous	S _____ T _____ R _____	_____
Property in Sec.	S _____ T _____ R _____	_____

Jean Hall
REG. OF DEEDS

Register of Deeds Stamp & File Number

Lot No. _____, Recorded Plat _____
Private Claims _____

	A	B	C	D	E	F	G	H	I	J	K	L	M
2	6		5		4		3		2		1		
3													
4	7		8		9		10		11		12		
5													
6	18		17		16		15		14		13		
7													
8	19		20		21		22		23		24		
9													
10	30		29		28		27		26		25		
11	●												
12	31		32		33		34		35		36		
13													

EUGENE FARRIER, in a field survey on NOV. 12, 19 94, hereby certify that under requirements of P.A. 74, Michigan P.A. of 1970, the corner points mentioned in lines 1 and 2 above were in conformance with regulations and rules therefore as required in the present manual of survey instructions of the United States Department of the Interior, Bureau of Land Management or by a decree of a Court of Law and/or that the corner points mentioned in lines 3, 4 and 5 were in conformance with the rules of the Michigan Board of Land Surveyors or by a Decree of a Court of Law; established, re-established, monumented, re-monumented, recovered, found as recorded below:

NOTE: Not more than 4 corners, all in the same town and range, may be recorded on this certificate.

Description of original monument and accessories and/or subsequent restoration:

B-11: Cor. common to Sec. 30 & 31, T27N-R6W
1850 GLO re-survey: set post, Beech 8", N75E, 15, Beech 6", S77E, 15
12-26-02, W.S. Merrill, noted cor., no accessories
10-72, C.F. Roser, Set DNR Mon. on st. line E & W & in line w/Fn N., no accessories.
1-11-73, LCRC(C.F. Roser), set DNR Monument, w/access, Lib 1 Pg 181
9-11-81, N.F. Parker, fd MDNR Mon., no access, Lib 2 Pg 822

Description of corner evidence found and/or method applied in restoring or reestablishing corner:

B-11: Cor. common to Sec. 30 & 31, T27N-R6W
Fd 1" pipe 8' N. C/L Tyler Rd. Pulled & replaced with 5/8" x 36" R.B. w/brass cap 0.4' below Rd. Surface.
On 12-20-94 the Kalkaska Co. peer group approved the above monument as the best available evidence of the position of the original corner.


Ratified by Peer Group
P.A. 345 - 1990 Kalkaska County

Chairman *Eugene Farrier*

Date 12-20-94

Description of monument for corner and accessories established to perpetuate locating the position of the corner:

B-11: Cor. common to Sec. 30 & 31, T27N-R6W
Fd 1" pipe 8' N. C.L. Tyler Rd. Pulled & replaced with 5/8" x 36" R.B. w/brass cap 0.4' below Rd. surface.
N10E, 30.85', set nail & tag FC. Cor.
S10W, 50.65', set nail & tag 6" Tw. Maple
S34W, 64.16', set nail & tag 15" Maple
S48W, 62.32', set nail & tag Fc. cor.

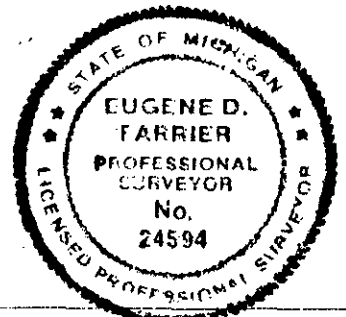

Recorded by *Eugene Farrier*

Date 12-22-94

Surveyor's Michigan License No. 24594