

SURVEY & REMONUMENTATION

MAR 21 1997

COMMISSION

KALKASKA COUNTY, MICHIGAN RECEIVED

97 JAN 31 PM 2: 26

LAND CORNER RECORDATION CERTIFICATE
Filing Requirement of Act 74, Mich. P.A. 1970

Jean Starr
 REG. DE. DEEDS

For corners in


KALKASKA
 (County)

Located In:

Corner Code #1

1996 REMONUMENTATION

- 1. Public Land Survey
 - T 26N R 6W
 - T T27N R 6W
 - T _____ R _____
 - T _____ R _____
- 2. Property Controlling in Section
 - S _____ T _____ R _____
 - S _____ T _____ R _____
- 3. Miscellaneous Property in Sec.
 - S _____ T _____ R _____
 - S _____ T _____ R _____

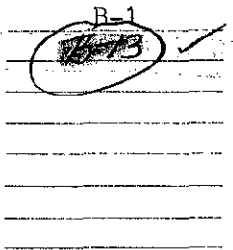

Register of Deeds Stamp & File Number

- 4. Lot No. _____, Recorded Plat _____
- 5. Private Claims _____

	A	B	C	D	E	F	G	H	I	J	K	L	M
2	6	5	4	3	2	1							
3													
4	7	8	9	10	11	12							
5													
6	16	17	16	15	14	13							
7													
8	19	20	21	22	23	24							
9													
10	30	29	28	27	26	25							
11													
12	31	32	33	34	35	36							
13													

I, EUGENE FARRIER, in a field survey on Nov. 14, 19 96

do hereby certify that under requirements of P.A. 74, Michigan P.A. of 1970, the corner points mentioned in lines 1 and 2 above were in conformance with regulations and rules therefore as required in the current manual of survey instructions of the United States Department of the Interior, Bureau of Land Management or by a decree of a Court of Law and/or that the corner points mentioned in lines 3, 4 and 5 above were in conformance with the rules of the Michigan Board of Land Surveyors or by a Decree of a Court of Law; established, re-established, monumented, re-monumented, recovered, found as expressed below:

NOTE: Not more than 4 corners, all in the same town and range, may be recorded on this certificate.

A. Description of original monument and accessories and/or subsequent restoration:

B-01: Cor. comn to Sec. 6, T26N-R6W, Oliver Township, Sec. 31, T27N-R6W, Excelsior Township
 Apr 21, 1839, GLO original survey, J.H.Mullett, set post. 8" Tamarach N66W 26, 8" Tamarach N03E 32.
 1888, E.Mosher, used corner, no accessories.
 11-10-1972, LCRC Liber 1 pg. 178.
 11-10-1972, C.L.Roser, set DNR mon, w/ accessories.
 09-24-1973, J.R.Radcliffe, fd DNR mon. Liber 1 pg.443 in Survey.
 09-24-1973, LCRC Liber 1 pg. 282.


3. Description of corner evidence found and/or method applied in restoring or reestablishing corner:

B-01: Cor. comn to Sec. 6, T26N-R6W, Oliver Township, Sec. 31, T27N-R6W, Excelsior Township
 Found DNR Mon w/ 4" x 4" Cedar Post w/ accessories. No G.L.O. witnesses found. The Kalkaska Co. peer group approved & accepted the above monument as a careful and faithful reestablishment of the position of the original corner.

Ratified by Peer Group
 P.A. 345 - 1990 Kalkaska County
 Chairman Eugene Farrier
 Date 1-21-97

2. Description of monument for corner and accessories established to perpetuate locating the position of the corner:

B-01: Cor. comn to Sec. 6, T26N-R6W, Oliver Township, Sec. 31, T27N-R6W, Excelsior Township
 Found DNR Mon w/ 4" x 4" Cedar Post w/ accessories.
 Set nail & tag S50W 4"x4" (DNR) Cedar Post, 1.22'
 N25W SE Cor Deer Blind, 34.71'
 Set nail & tag North 6" Wood Fence Post, 45.32'
 Set nail & tag N55E 11" W.Pine, 63.95'

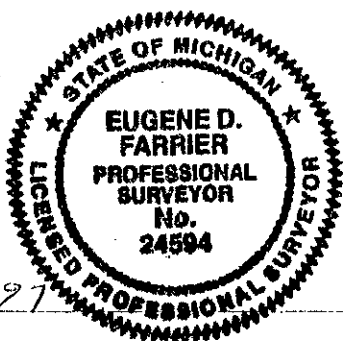

igned by Eugene Farrier
 urveyor's Michigan License No. 24594

Date 1-30-97