

**SURVEY & REMONUMENTATION**

MAY 10 1999

KALKASKA COUNTY, MICHIGAN RECEIVED

SECTION

LAND CORNER RECORDATION CERTIFICATE

1994 DEC 23 AM 9:14

Filing Requirement of Act 74, Mich. P.A. 1970

corners in

(County) 1994 REMONUMENTATION Public Land Survey	Located In: T 27N R 6W	Corner Code #: C-7
Property Controlling	S _____ T _____ R _____	_____
(In Section	S _____ T _____ R _____	_____
Miscellaneous	S _____ T _____ R _____	_____
Property in Sec.	S _____ T _____ R _____	_____

*Jean Hall*  
REG. OF DEEDS

Register of Deeds Stamp & File Number

Lot No. \_\_\_\_\_, Recorded Plat \_\_\_\_\_  
Private Claims \_\_\_\_\_

	A	B	C	D	E	F	G	H	I	J	K	L	M
2	6	5	4	3	2	1							
3													
4	7	8	9	10	11	12							
5													
6	18	17	16	15	14	13							
7													
8	19	20	21	22	23	24							
9													
10	30	29	28	27	26	25							
11													
12	31	32	33	34	35	36							
13													

EUGENE FARRIER, in a field survey on NOV. 12, 1994, hereby certify that under requirements of P.A. 74, Michigan P.A. of 1970, the corner points mentioned in lines 1 and 2 above were in conformance with regulations and rules therefore as required in the rent manual of survey instructions of the United States Department of the Interior, Bureau of Land Management or by a decree of a Court of Law and/or that the corner points mentioned in lines 3, 4 and 5 above were in conformance with the rules of the Michigan Board of Land Surveyors or by a Decree of a Court of Law; established; re-established, monumented, re-monumented, recovered, found as pressed below:

**NOTE: Not more than 4 corners, all in the same town and range, may be recorded on this certificate.**

Description of original monument and accessories and/or subsequent restoration:

C-7: Cor. common to Sec. 17, 18, 19 & 20, T27N-R6W  
 1850 GLO re-survey: set post, Sugar 15", N17E, 20, Lynn 16", S64W, 6  
 6-5-1888, E. Mosher, noted cor., no accessories  
 5-6-01, W.S. Merrill, noted cor., no accessories  
 4-4-11, W.S. Merrill, noted stone cor., no accessories  
 6-13-28, W.S. Merrill, noted cor, no access, B. Shores, Lib A Pg's 70&71  
 8-10-57, A.G. Erickson, noted cor., no accessories  
 4-20-68, C.M. Mitchell, noted ocr., no access., Crw. Lk Est. Plat  
 2-4-72, LCRC(N.F. Parker) fd 1/2" bar, w/access, Lib 1 Pg 53  
 5-23-74, LCRC(D.E. Porter), fd 1/2" rod, w/access, Lib 1 Pg 317  
 5-71 to 8-93, Certificates of Surveys, all fd 1/2" iron, J.L. Wilcox(Lib 1 Pg 283), J.F. Erickson(Lib D Pg's 35, 36, 46, & 47), J.L. Fletcher(Lib 1 Pg's 671 & 849, Lib 2 Pg 193), N.F. Parker(Lib 1 Pg's 83 & 706), E. Farrier(Lib 3 Pg's 29 & 332, also 8 other surv. w/no Lib & Pg)


Description of corner evidence found and/or method applied in restoring or reestablishing corner:

C-7: Cor. common to Sec. 17, 18, 19 & 20, T27N-R6W  
 Fd 1/2" x 18" R.B. Pulled and set 5/8" x 18" R.B. w/brass cap in Mon. Box 1' width, C.L. Crawford Lk Rd. & 0.4' below surface. No GLO witnesses were fd.  
 On 12-20-94 the Kalkaska Co. peer group approved the above monument as a careful and faithful reestablishment of the position of the original corner.

Ratified by Peer Group  
 P.A. 345 - 1990 Kalkaska County  
 Chairman *[Signature]*  
 Date 12-22-94

Description of monument for corner and accessories established to perpetuate locating the position of the corner:

C-7: Cor. common to Sec. 17, 18, 19 & 20, T27N-R6W  
 Fd 1/2" x 18" R.B. Pulled and set 5/8" x 18" R.B. w/brass cap in Mon. Box 1' West C.L. Crawford Lk Rd. & 0.4' below surface.  
 N44W, 51.97' set nail in corn. post (split rail fence)  
 N45E, 46.65' fd iron & cap #14102  
 S52E, 51.97' set nail in 4 high guard post  
 S38W, 74.32' fd Conc. mon.

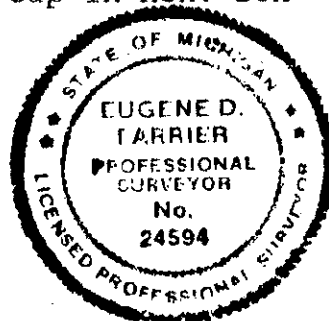

Surveyed by *[Signature]*

Date 12-22-94

Surveyor's Michigan License No. 24594