SURVEY & REMONUMENTATION

MAY 1 0 1999

KALKASKA COUNTY, MICHIGAN
RECEIVED
1994 DEC 23 AM 9: 14
Joan Hall
REG. OF DEEDS

LAND CORNER RECORDATION CERTIFICATE

Filing Requirement of Act 74, Mich. P.A. 1970

r corners in SECTION

KALKASKA (County)

1994 REMONUMENTATION

		Located In:	Corner Code #
Public Land Survey		T 27N R 6W	C-8
		T ___ R ___	
		T ___ R ___	
		T ___ R ___	
Property Controlling	S ___	T ___ R ___	
in Section	S ___	T ___ R ___	
Miscellaneous	S ___	T ___ R ___	
Property in Sec.	S ___	T ___ R ___	

Register of Deeds Stamp & File Number

Lot No. _____, Recorded Plat _____

Private Claims _____

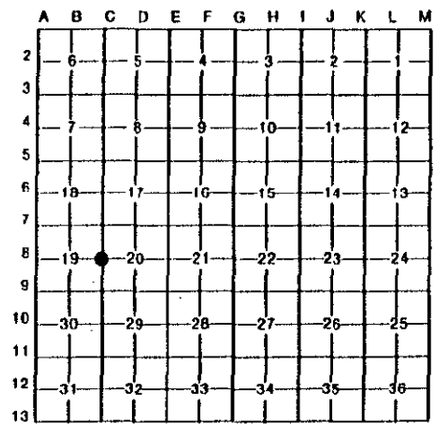

EUGENE FARRIER, in a field survey on NOV. 12, 19 94, hereby certify that under requirements of P.A. 74, Michigan P.A. of 1970, the corner points mentioned ines 1 and 2 above were in conformance with regulations and rules therefore as required in the rent manual of survey instructions of the United States Department of the Interior, Bureau of Land nagement or by a decree of a Court of Law and/or that the corner points mentioned in lines 3, 4 and 5 ve were in conformance with the rules of the Michigan Board of Land Surveyors or by a Decree of a rt of Law; established, re-established, monumented, re-monumented, recovered, found as ressed below:

TE: Not more than 4 corners, all in the same town and range, may be recorded on this certificate.

Description of original monument and accessories and/or subsequent restoration:

C-8: Cor. common to Sec. 19 & 20, T27N-R6W
1850 GLO re-survey: set post, Beech 8", S52W, 6, Beech 8", North, 9
6-5-1888, E. Mosher, noted cor., no accessories
8-10-57, A.G. Erickson, cor. no fd, no accessories
9-19-73, LCRC(L.L. Cavanaugh), fd 1/2" bar, w/access., Lib 1 pg 254
5-23-74, LCRC(D.E.Porter), fd 1/2" rod, w/access., Lib 1 Pg 317
5-71 to 8-92, Certificates of Survey, all fd 1/2" rod, J.F. Erickson(Lib D Pg's 35, 36, 46 & 47), J.L. Fletcher(Lib 1 Pg 849, Lib 2 Pg 185), N.F. Parker (fd cor. no wit.), E. Farrier(5 seperate surv. w/no Lib & Pg)

Description of corner evidence found and/or method applied in restoring or reestablishing corner:

C-8: Cor. common to Sec. 19 & 20, T27N-R6W
Fd 1/2" x 24" R.B., pulled & set 5/8" x 18" R.B. w/brass cap in Mon. box in C.L. Crawford Lk Rd. & 0.4' below surface. No GLO witness were fd. On 12-20-94 the Kalkaska Co. peer group approved the above monument as a careful and faithful reestablishment of the position of the original corner.

Ratified by Peer Group
P.A. 345 - 1990 Kalkaska County
Chairman [signature]
Date 12-20-94

Description of monument for corner and accessories established to perpetuate locating the position of the corner:

C-8: Cor. common to Sec. 19 & 20, T27N-R6W
Fd 1/2" x 24" R.B., pulled & set 5/8" x 18" R.B. w/brass cap in Mon. box in C.L. Crawford Lk Rd. & 0.4' below surface.
N57E, 45.97', set nail 26" Maple
S70E, 46.00', set nail 26" Maple
S69W, 55.36', set nail 6" R. Pine
West, 60.21', fd nail P. Pole

STATE OF MICHIGAN
EUGENE D. FARRIER
PROFESSIONAL SURVEYOR
No. 24594
LICENSED PROFESSIONAL SURVEYOR

ed by [signature] Date 12-22-94

eyor's Michigan License No. 24594

FORM APPROVED BY MICHIGAN STATE BOARD OF LAND SURVEYORS, JAN. 28, 1971
REVISED MAY 14, 1975
REVISED JAN., 1983