

SURVEY & REMONUMENTATION

MAY 10 1999

KALKASKA COUNTY, MICHIGAN RECEIVED

LAND CORNER RECORDATION CERTIFICATE
Filing Requirement of Act 74, Mich. P.A. 1970

DEC 23 AM 9:18

Joan Hall
 REG. OF DEEDS

SECTION
 corners in

KALKASKA (County)	Located In:	Corner Code #
1994 REMONUMENTATION Public Land Survey	T 27N R 6W	C-11
	T _____ R _____	_____
	T _____ R _____	_____
	T _____ R _____	_____
Property Controlling in Section	S _____ T _____ R _____	_____
Miscellaneous Property in Sec.	S _____ T _____ R _____	_____

Register of Deeds Stamp & File Number

Lot No. _____, Recorded Plat _____
 Private Claims _____

EUGENE FARRIER, in a field survey on NOV. 12, 19 94, hereby certify that under requirements of P.A. 74, Michigan P.A. of 1970, the corner points mentioned in lines 1 and 2 above were in conformance with regulations and rules therefore as required in the present manual of survey instructions of the United States Department of the Interior, Bureau of Land Management or by a decree of a Court of Law and/or that the corner points mentioned in lines 3, 4 and 5 above were in conformance with the rules of the Michigan Board of Land Surveyors or by a Decree of a Court of Law, established, re-established, monumented, re-monumented, recovered, found as recorded below:

NOTE: Not more than 4 corners, all in the same town and range, may be recorded on this certificate.


	A	B	C	D	E	F	G	H	I	J	K	L	M
2	6		5		4		3		2		1		
3													
4	7		8		9		10		11		12		
5													
6	18		17		16		15		14		13		
7													
8	19		20		21		22		23		24		
9													
10	30		29		28		27		26		25		
11													
12	31		32		33		34		35		36		
13													

Description of original monument and accessories and/or subsequent restoration:
 C-11: Cor. common to Sec. 29, 30, 31 & 32, T27N-R6W
 1850 GLO re-survey: set post, Sugar 14", N60E, 23, Sugar 12", S67W, 22
 6-3-1889, E. Mosher, noted cor., no accessories
 12-26-02, W.S. Merrill, noted cor., no accessories
 11-9 & 12-7-04, W.S. Merrill, noted iron stake at cor., no accessories
 11-72, C.F. Roser, fd ir. by J. Erickson, no accessories
 1-11-73, C.F. Roser, fd 1/2" rerod w/#16929, w/accessories
 9-26-73, J. R. Radcliffe, fd 1/2" rerod w/cap, w/access, Lib 1 Pg 282
 6-15-74, W. Downey, noted cor., no access.,
 Kalkaska Co Rd Comm, noted cor., w/access.,
 11-11-80, J. L. Fletcher, fd 1/2" re-rod, w/access, Lib 2 Pg 599
 9-11-81, J.F. Parker, fd ir. set by J. Erickson, no access, Lib 2 Pg 822
 6-8-90, E. Farrier, fd 1/2" re-rod, w/access.,

Description of corner evidence found and/or method applied in restoring or reestablishing corner:
 C-11: Cor. common to Sec. 29, 30, 31 & 32, T27N-R6W
 Fd 1/2" x 18" R.B. Pulled & replaced with 5/8" x 36" R.B. 0.6' below rd. surface w/brass cap. No GLO wit. were fd
 On 12-20-94 the Kalkaska Co. peer group approved the above monument as a careful and faithful reestablishment of the position of the original corner.

Ratified by Peer Group
 P.A. 345 - 1990 Kalkaska County
 Chairman *Eugene Farrier*
 Date 12-20-94

Description of monument for corner and accessories established to perpetuate locating the position of the corner:
 C-11: Cor. common to Sec. 29, 30, 31 & 32, T27N-R6W
 Fd 1/2" x 18" R.B. Pulled & replaced with 5/8" x 36 R.B. 0.6' below rd. surface w/brass cap.
 N62W, 55.56', C.P. Riser
 S51E, 58.55, set nail & tag Fe cor.
 S28E, 62.26', set nail & tag P. Pole
 S66W, 113.85', set nail & tag 20" Maple

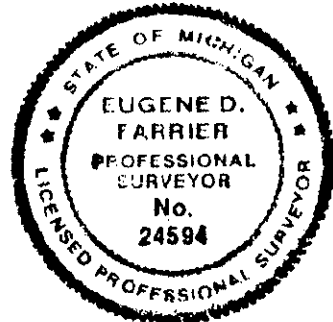

Recorded by *Eugene Farrier* Date 12-22-94
 Surveyor's Michigan License No. 24594

FORM APPROVED BY MICHIGAN STATE BOARD OF LAND SURVEYORS, JAN. 28, 1971
 REVISED MAY 14, 1975
 REVISED JAN., 1983