

**SURVEY &
REMONUMENTATION**

MAR 21 1997

COMMISSION

LAND CORNER RECORDATION CERTIFICATE
Filing Requirement of Act 74, Mich. P.A. 1970

KALKASKA COUNTY, MICH.
RECEIVED
97 JAN 31 PM 4:00

For corners in

KALKASKA

(County)

Located In:

Corner Code: //

1996 REMONUMENTATION

1. Public Land Survey

T 26N R 6W

T 27N R 6W

T _____ R _____

T _____ R _____

2. Property Controlling
In Section

S _____ T _____ R _____

S _____ T _____ R _____

3. Miscellaneous
Property in Sec.

S _____ T _____ R _____

S _____ T _____ R _____

D-1
D-13 ✓

Joan Hall
REG. DEEDS

Register of Deeds Stamp & File Number

4. Lot No. _____, Recorded Plat _____

5. Private Claims _____

	A	B	C	D	E	F	G	H	I	J	K	L	M
2	6		5		4		3		2				
3													
4	7		8		9		10		11		12		
5													
6	18		17		16		15		14		13		
7													
8	19		20		21		22		23		24		
9													
10	30		29		28		27		26		25		
11													
12	31		32		33		34		35		36		
13													

I, EUGENE FARRIER, in a field survey on Nov. 18, 1996

do hereby certify that under requirements of P.A. 74, Michigan P.A. of 1970, the corner points mentioned in lines 1 and 2 above were in conformance with regulations and rules therefore as required in the current manual of survey instructions of the United States Department of the Interior, Bureau of Land Management or by a decree of a Court of Law and/or that the corner points mentioned in lines 3, 4 and 5 above were in conformance with the rules of the Michigan Board of Land Surveyors or by a Decree of a Court of Law; established, re-established, monumented, re-monumented, recovered, found as expressed below:

NOTE: Not more than 4 corners, all in the same town and range, may be recorded on this certificate.

A. Description of original monument and accessories and/or subsequent restoration:

D-01 cor common to Sec. 5, T26N-R6W, Oliver Township & Sec. 32, T27N-R6W, Excelsior Township
Apr 21, 1839, GLO original survey, J.H. Mullett, Set Post. 8" Beech N10W 35° 12" Hemlock N47E 38.
1888, E. Mosher, Co. Surveyor, used corner, no accessories.
11-09-1904, W.S. Merrill, Co. Surveyor, used corner, Gov. Surv. Bearing trees
04-16-1973, N.F. Parker, used corner. Liber 1 pg. 305 of Survey.
01-30-1975, N.F. Parker, used corner. Liber 1 pg. 641 of Survey.
01-30-1975, LCRC Liber 1 pg. 347.
6-08-1990, E.D. Farrier, Survey #6490, fd iron & cap #16939, w/ accessories.

B. Description of corner evidence found and/or method applied in restoring or reestablishing corner:

D-01 cor common to Sec. 5, T26N-R6W, Oliver Township & Sec. 32, T27N-R6W, Excelsior Township
Found 1/2" x 18" R.B w/ cap #16839 w/ accessories. Pulled & Set 5/8" x 36" re-rod w/ Aluminum cap. No G.L.O witnesses found. The Kalkaska Co. peer group approved & accepted the above monument as the best available evidence of the position of the original corner.


Ratified by Peer Group
P.A. 345 - 1990 Kalkaska County

Chairman *Eugene Farrier*

Date 1-21-97

C. Description of monument for corner and accessories established to perpetuate locating the position of the corner:

D-01 cor common to Sec. 5, T26N-R6W, Oliver Township & Sec. 32, T27N-R6W, Excelsior Township
Found 1/2" x 18" R.B w/ cap #16839 w/ accessories. Pulled & Set 5/8" x 36" re-rod w/ Aluminum cap.
Set nail & tag N20E 10" Maple, 6.24'
Set nail & tag N80E 8" Maple, 14.87'
Set nail & tag S13W 7" Maple, 15.38'
Set nail & tag S68W 7" Maple, 10.92'

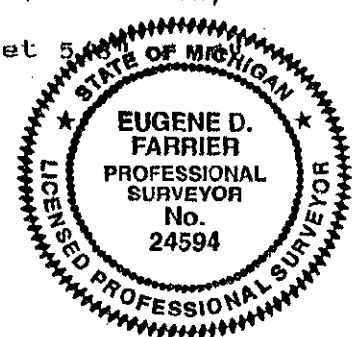

Signed by *Eugene Farrier*

Date 1-30-97

Surveyor's Michigan License No. 24594