

SURVEY & REMONUMENTATION

KALKASKA COUNTY, MICHIGAN
RECEIVED

MAR 21 1997

AND CORNER RECORDATION CERTIFICATE 97 JAN 31 PM 2:44

COMMISSION

Recording Requirement of Act 74, Mich. P.A. 1970

For corners in

KALKASKA

(County)

Located In:

Corner Code -##

James Hall
MICHIGAN

1996 REMONUMENTATION

1. Public Land Survey

T 26N R 6W
T 27N R 6W

E-1



2. Property Controlling

S _____ T _____ R _____

in Section

S _____ T _____ R _____

3. Miscellaneous

S _____ T _____ R _____

Property in Sec.

S _____ T _____ R _____

Register of Deeds Stamp & File Number

1. Lot No. _____, Recorded Plat _____

5. Private Claims _____

EUGENE FARRIER

Nov. 21

19 96

to hereby certify that under requirements of P.A. 74, Michigan P.A. of 1970, the corner points mentioned in lines 1 and 2 above were in conformance with regulations and rules therefore as required in the current manual of survey instructions of the United States Department of the Interior, Bureau of Land Management or by a decree of a Court of Law and/or that the corner points mentioned in lines 3, 4 and 5 above were in conformance with the rules of the Michigan Board of Land Surveyors or by a Decree of a Court of Law; established, re-established, monumented, re-monumented, recovered, found as expressed below:

NOTE: Not more than 4 corners, all in the same town and range, may be recorded on this certificate.

	A	B	C	D	E	F	G	H	I	J	K	L	M
2	6		5		4		3		2				
3													
4	7		8		9		10		11		12		
5													
6	10		17		16		15		14		13		
7													
8	19		20		21		22		23		24		
9													
10	30		29		28		27		26		25		
11													
12	31		32		33		34		35		36		
13													

4. Description of original monument and accessories and/or subsequent restoration:

E-01 cor common to Sec. 4 & 5, T26N-R6W, Oliver Township & Sec. 32 & 33, T27N-R6W, Excelsior Township
1852, GLO resurvey, Set Post. 10"B. Ash N29W 15, 10"B. Ash N12E 16.
09-19-1887, E.Mosher, Co. Surveyor, used corner, no accessories.
1888, E.Mosher, Co. Surveyor, used corner, no accessories.
09-02-1903, W.S.Merrill, Co. Surveyor, used corner, no accessories.
11-09-1904, W.S.Merrill, Co. Surveyor, used corner, no accessories.
09-02-1959, K.J.Ostling, 27lks. North of squareppst, set from 2 possible witnesses.
07-13-1974, LCRC Liber 1 pg. 327.
11-09-1978, LCRC Liber 2 pg. 136.
04-25-1979, J.L.Fletcher, fd. 1" iron pipe. Liber 2 pg.345 of Survey.
04-25-1979, LCRC Liber 2 pg. 177.
10-19-1982, DNR, fd 3/4" pipe, no accessories.
06-12-1986, N.B.DeYoung, fd 1" iron pipe, w/ accessories.
12-21-1987, J.L.Schwandt, fd 3/4" iron rod. Liber 3 pg 191 of Survey.
05-22-1990, Farrier Surveying, Survey #6490, fd 5/8" iron pipe thin wall, no accessories.
06-08-1990, E.D.Farrier, Survey #6490, fd 3/4" pipe, w/ accessories.

5. Description of corner evidence found and/or method applied in restoring or reestablishing corner:

E-01 cor common to Sec. 4 & 5, T26N-R6W, Oliver Township & Sec. 32 & 33, T27N-R6W, Excelsior Township
Found 3/4" x 18" Iron Pipe w/ accessories. Pulled & Set 5/8" x 18" re-rod w/ Brass cap in Mon Box 1.5' East of centerline of Sigma Road. No GLO witnesses found. The Kalkaska Co. peer group approved & accepted the above monument as a careful and faithful reestablishment of the position of the original corner.

6. Description of monument for corner and accessories established to perpetuate locating the position of the corner:


E-01 cor common to Sec. 4 & 5, T26N-R6W, Oliver Township & Sec. 32 & 33, T27N-R6W, Excelsior Township
Found 3/4" x 18" Iron Pipe w/ accessories. Pulled & Set 5/8" x 18" re-rod w/ Brass cap in Mon Box 1.5' East of centerline of Sigma Road.
Set nail & tag West 4"x4" Cedar Post, 33.52'
Set nail & tag N65E 4" Beech, 30.30'
Set nail & tag S54E Power Pole, 57.37'
Set nail & tag S36W 6" Beech, 45.42'

signed by *Eugene Farrier*

Date 1-30-97

Surveyor's Michigan License No. 24594

Ratified by Peer Group
P.A. 345 - 1990 Kalkaska County
Chairman *Eugene Farrier*
Date 1-21-97

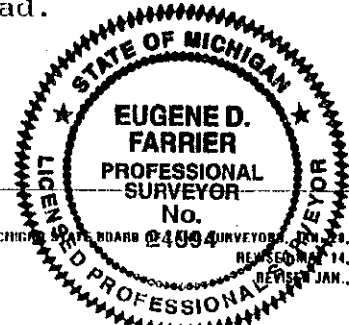

FORM APPROVED BY MICHIGAN STATE BOARD OF SURVEYORS, JAN. 29, 1974
REVISED JAN. 14, 1975
REVISED JAN., 1993