

**SURVEY & REMONUMENTATION**

JUL 02 1999

KALKASKA COUNTY, MICHIGAN  
RECEIVED

SECTION

AND CORNER RECORDATION CERTIFICATE 1994 DEC 23 AM 9:26  
Filing Requirement of Act 74, Mich. P.A. 1970

corners in

ALKASKA (County)	Located In:	Corner Code #/
1994 REMONUMENTATION		
Public Land Survey	T 27N R 6W	G-10
	T R	
	T R	
	T R	
Property Controlling in Section	S T R	
Miscellaneous	S T R	
Property in Sec.	S T R	

*Joan Hall*  
REG. OF DEEDS

Register of Deeds Stamp & File Number

Lot No. \_\_\_\_\_, Recorded Plat \_\_\_\_\_  
Private Claims \_\_\_\_\_

EUGENE FARRIER, in a field survey on NOV. 12, 1994, hereby certify that under requirements of P.A. 74, Michigan P.A. of 1970, the corner points mentioned in lines 1 and 2 above were in conformance with regulations and rules therefore as required in the current manual of survey instructions of the United States Department of the Interior, Bureau of Land Management or by a decree of a Court of Law and/or that the corner points mentioned in lines 3, 4 and 5 above were in conformance with the rules of the Michigan Board of Land Surveyors or by a Decree of a Court of Law; established, re-established, monumented, re-monumented, recovered, found as recorded below:

**FE: Not more than 4 corners, all in the same town and range, may be recorded on this certificate.**

Description of original monument and accessories and/or subsequent restoration:

G-10: Cor. common to Sec. 27 & 28, T27N-R6W, Excelsior Twp.  
1850 GLO re-survey: set post in border of stream, Cedar 14", S35E, 38, Tamarack 12", N34.5W, 21.  
5-17-56, Depart. of Conservation Land Corner Record. Fd Cedar post at corner in stream, set pipe w/brass cap for witness 10 links North.  
1955-56, K. Ostling, working drawing from DNR.  
12-17-71, Wilcox Assoc., used corner. Lib 1 Pg 53


Description of corner evidence found and/or method applied in restoring or reestablishing corner:

G-10: Cor. common to Sec. 27 & 28, T27N-R6W, Excelsior Twp.  
Fd DNR Mon. 3' N. edge of creek as witness 6.6' North of corner location.  
Corner was set in creek by DNR. Did not find corner.  
Stamped DNR Mon. as witness with Remon Info.  
On 12-20-94 the Kalkaska Co. peer group approved the above monument as a careful and faithful perpetuation of the position of the original corner.

Ratified by Peer Group  
P.A. 345 - 1990 Kalkaska County  
Chairman *Eugene Farrier*  
Date 12-20-94

Description of monument for corner and accessories established to perpetuate locating the position of the corner:

G-10: Cor. common to Sec. 27 & 28, T27N-R6W, Excelsior Twp.  
Fd DNR Witness Mon. 3' N. edge of creek. with 5/8" x 36" R.B. w/alu. cap at ground level.  
S64E, 38.12', NBT 10" Cedar  
N32W, 24.17', NBT 9" Cedar  
N07W, 6.20', fd nail 10" Hemlock  
S20E, 4.17', fd nail 6" Iron Wood  
S62W, 6.90', fd nail 10" Cedar  
N80W, 10.95', fd nail 8" Maple

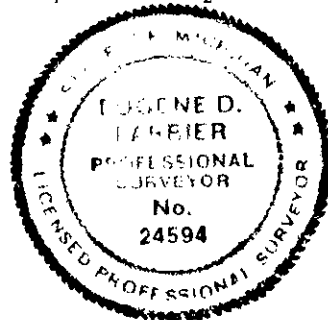

Recorded by *Eugene Farrier*

Date 12-22-94

Surveyor's Michigan License No. 24594