

SURVEY & REMONUMENTATION

MAY 10 1999

KALKASKA COUNTY, MICHIGAN RECEIVED

1994 DEC 23 AM 9:26

LAND CORNER RECORDATION CERTIFICATE Filing Requirement of Act 74, Mich. P.A. 1970

Jean Hall REG. OF DEEDS

SECTION

or corners in

Form with fields for KALKASKA (County), Located In: T 27N R 6W, Corner Code # H-9, and Property Controlling in Section.

Register of Deeds Stamp & File Number

Lot No. Recorded Plat Private Claims

EUGENE FARRIER, in a field survey on NOV. 12, 1994, hereby certify that under requirements of P.A. 74, Michigan P.A. of 1970, the corner points mentioned lines 1 and 2 above were in conformance with regulations and rules...

NOTE: Not more than 4 corners, all in the same town and range, may be recorded on this certificate.

Grid table with columns A-M and rows 2-13, containing numbers 1-36 and a dot at row 9, column G.

Description of original monument and accessories and/or subsequent restoration:

- H-9: Cor. common to Sec. 22 & 27, T27N-R6W 1850 GLO re-survey: set post, B.Ash 16", S40W, 12, Y.Birch 12", N28E, 15 8-11-1880, D.E. McVee, noted cor., no access 8-27-03, W.S. Merrill, gov't. bear. trees, w/accessories 3-29-06, W.S. Merrill, stmps of orig. bear trees, w/accessories 1955, K.J. Ostling, set marker N. of rd, w/accessories 1936, MDOT, Right-of-way map, notes cor., no accessories 2-93, Wilcox Assoc., notes cor., no accessories


Description of corner evidence found and/or method applied in restoring or reestablishing corner:

H-9: Cor. common to Sec. 22 & 27, T27N-R6W Set 5/8" x 18" rerod w/brass cap. 13' N. of C/L M-72 and 0.30' below surface in Mon. Box. 1.0' into shoulder. Set S.P. to Merrill. On 12-20-94 the Kalkaska Co. peer group approved the above monument as a careful and faithful reestablishment of the position of the original corner.

Ratified by Peer Group P.A. 345 - 1990 Kalkaska County Chairman [Signature] Date 12-20-94

Description of monument for corner and accessories established to perpetuate locating the position of the corner:

- H-9: Cor. common to Sec. 22 & 27, T27N-R6W Set 5/8" x 18" rerod w/brass cap. 13' N. of C/L M-72 and 0.30' below surface in Mon. Box. 1.0' into shoulder. Set S.P. to Merrill. S39E, 146.36', set nail 15" Black Ash S18E, 69.36', set nail 18" Black Ash S46W, 132.42', set nail 12" Cedar N79E, 158.79', set nail Power Pole

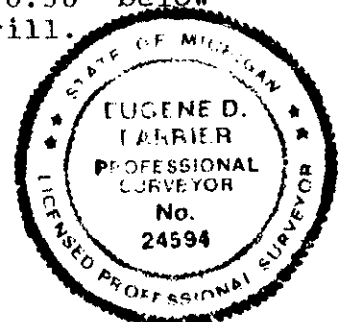

ed by [Signature]

Date 12-22-94

eyor's Michigan License No. 24594