

**SURVEY & REMONUMENTATION**

MAY 10 1999

KALKASKA COUNTY, MICHIGAN RECEIVED

1994 DEC 23 AM 9:26

SECTION

**LAND CORNER RECORDATION CERTIFICATE**  
Filing Requirement of Act 74, Mich. P.A. 1970

*Jean Hall*  
REG. OF DEEDS

corners in

<u>KALKASKA</u> (County)	Located In:	Corner Code <u>J-9</u>
1994 REMONUMENTATION Public Land Survey	T <u>27N</u> R <u>6W</u>	
	T _____ R _____	
	T _____ R _____	
	T _____ R _____	
Property Controlling in Section	S _____ T _____ R _____	
Miscellaneous Property in Sec.	S _____ T _____ R _____	

Register of Deeds Stamp & File Number

Lot No. \_\_\_\_\_, Recorded Plat \_\_\_\_\_  
Private Claims \_\_\_\_\_

	A	B	C	D	E	F	G	H	I	J	K	L	M
2	6		5		4		3		2				
3													
4	7		8		9		10		11		12		
5													
6	18		17		16		15		14		13		
7													
8	19		20		21		22		23		24		
9													
10	30		29		28		27		26		25		
11													
12	31		32		33		34		35		36		
13													

EUGENE FARRIER, in a field survey on NOV. 12, 1994, hereby certify that under requirements of P.A. 74, Michigan P.A. of 1970, the corner points mentioned in lines 1 and 2 above were in conformance with regulations and rules therefore as required in the present manual of survey instructions of the United States Department of the Interior, Bureau of Land Management or by a decree of a Court of Law and/or that the corner points mentioned in lines 3, 4 and 5 above were in conformance with the rules of the Michigan Board of Land Surveyors or by a Decree of a Court of Law; established, re-established, monumented, re-monumented, recovered, found as pressed below:

**NOTE: Not more than 4 corners, all in the same town and range, may be recorded on this certificate.**

Description of original monument and accessories and/or subsequent restoration:

- J-9: cor. common to Sec. 23 & 26, T27N-R6W
- 1850 GLO re-survey: set post, Sugar 8", S50E, 43, Beech 8", N75W, 22
- 7-22-1876, D.E. McVee, noted cor., no access.
- 12-3-03, W.S. Merrill, noted cor., no access.
- 1936, MDOT, right-of-way map, noted cor., no access.
- Unknown date, Kalkaska Co Rd Comm, noted cor., no access.
- 1955, K.J. Ostling, noted cor., no access.
- 8-8-79, LCRC(N.F. Parker), fd pk nail, set 1/2" x 18" bar, w/access, Lib 2 Pg 187
- 8-8-79, N.F. Parker, noted 1/2" bar, w/accessories, Lib 2 Pg's 386 & 387
- 2-93, Wilcox Assoc., noted cor., no accessories


Description of corner evidence found and/or method applied in restoring or reestablishing corner:

J-9: cor. common to Sec. 23 & 26, T27N-R6W  
Fd 1/2" x 36" re-rod, pulled & set 5/8" x 18" R.B. & brass cap 5' N. C.L. M-72 & 0.4' below surface. No GLO witness were fd  
On 12-20-94 the Kalkaska Co. peer group approved the above monument as a careful and faithful reestablishment of the position of the original corner.

Ratified by Peer Group  
P.A. 345 - 1990 Kalkaska County  
Chairman *Eugene Farrier*  
Date 12-20-94

Description of monument for corner and accessories established to perpetuate locating the position of the corner:

- J-9: cor. common to Sec. 23 & 26, T27N-R6W
- Fd 1/2" x 36" re-rod, pulled & set 5/8" x 18" R.B. & brass cap 5' N. C.L. M-72 & 0.4' below surface.
- N33W, 55.68', top ctr cor. steel fnc post
- South, 56.23', Conc. Mon.
- S18W, 86.80', fd nail 8" R. Pine
- N68E, 148.54', fd nail P. Pole

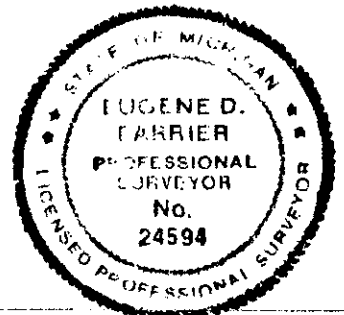

Surveyed by *Eugene Farrier* Date 12-22-94  
Surveyor's Michigan License No. 24594