

SURVEY & REMONUMENTATION

MAY 10 1999

KALKASKA COUNTY, MICHIGAN RECEIVED

1994 DEC 23 AM 9:26

SECTION

LAND CORNER RECORDATION CERTIFICATE Filing Requirement of Act 74, Mich. P.A. 1970

Joan Hall REG. OF DEEDS

corners in

Table with columns: (County), Located In, Corner Code #. Rows include 1994 REMONUMENTATION Public Land Survey, Property Controlling in Section, Miscellaneous Property in Sec.

Register of Deeds Stamp & File Number

Lot No. Recorded Plat Private Claims

Grid table with columns A-M and rows 2-13. Contains numbers 1-36 and a dot in row 9, column J.

EUGENE FARRIER, in a field survey on NOV. 12, 1994, hereby certify that under requirements of P.A. 74, Michigan P.A. of 1970, the corner points mentioned in lines 1 and 2 above were in conformance with regulations and rules therefore as required in the recent manual of survey instructions of the United States Department of the Interior, Bureau of Land Management or by a decree of a Court of Law and/or that the corner points mentioned in lines 3, 4 and 5 above were in conformance with the rules of the Michigan Board of Land Surveyors or by a Decree of a Court of Law; established, re-established, monumented, re-monumented, recovered, found as recited below:

NOTE: Not more than 4 corners, all in the same town and range, may be recorded on this certificate.

Description of original monument and accessories and/or subsequent restoration:

- K-9: Cor. common to Sec. 23, 24, 25 & 26, T27N-R6W
1850 GLO re-survey: set post, Hemlock 30", N85W, 20, Beech 6", S53E, 11
7-22-1876, D.E. McVee, noted cor., no accessories
8-10-1885, E. Mosher, noted cor., no accessories
12-4-03, W.S. Merrill, noted cor., no accessories
1936, MDOT, Right-of-way, noted cor., no accessories
1955, K.J. Ostling, noted cor., w/accessories
8-8-79, N.F. Parker, fd cor., no accessories,
2-93, Wilcox Assoc., noted triangular iron in mon. box, w/accessories


Description of corner evidence found and/or method applied in restoring or reestablishing corner:

K-9: Cor. common to Sec. 23, 24, 25 & 26, T27N-R6W
Fd 1/2" x 36" R.B., pulled & set 5/8" x 36" R.B. & brass cap in C.L. rd. int. 0.4' below surface. No GLO witnesses were fd.
On 12-20-94 the Kalkaska Co. peer group approved the above monument as a careful and faithful reestablishment of the position of the original corner.

Ratified by Peer Group
P.A. 345 - 1990 Kalkaska County
Chairman [Signature]
Date 12-20-94

Description of monument for corner and accessories established to perpetuate locating the position of the corner:

- K-9: Cor. common to Sec. 23, 24, 25 & 26, T27N-R6W
Fd 1/2" x 36" R.B., pulled & set 5/8" x 36" R.B. & brass cap in C.L. rd. int. 0.4' below surface.
S45W, 102.88', NE cor. hse fd
S43E, 67.38', fd nail 10" Maple
N10W, 74.23', fd nail 24" W. Pine
N42E, 56.46', fd nail 15" Maple

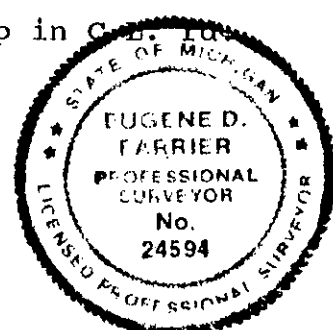

Recorded by [Signature] Date 12-22-94
Surveyor's Michigan License No. 24594