SURVEY &
REMONUMENTATION

MAY 1 0 1999

SECTION

KALKASKA COUNTY, MICHIGAN
RECEIVED
1994 DEC 23 AM 9:28
REG. OF DEEDS

LAND CORNER RECORDATION CERTIFICATE

Filing Requirement of Act 74, Mich. P.A. 1970

r corners in

KALKASKA (County)

1994 REMONUMENTATION

		Located In:	Corner Code #
Public Land Survey		T 27N R 6W	M-9
		T ___ R ___	
		T ___ R ___	
		T ___ R ___	
Property Controlling	S ___	T ___ R ___	
in Section	S ___	T ___ R ___	
Miscellaneous	S ___	T ___ R ___	
Property in Sec.	S ___	T ___ R ___	

Register of Deeds Stamp & File Number

Lot No. _____, Recorded Plat _____

Private Claims _____

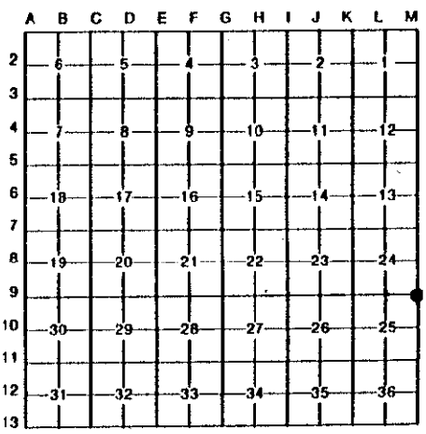

EUGENE FARRIER, in a field survey on NOV. 12, 19 94, hereby certify that under requirements of P.A. 74, Michigan P.A. of 1970, the corner points mentioned lines 1 and 2 above were in conformance with regulations and rules therefore as required in the rent manual of survey instructions of the United States Department of the Interior, Bureau of Land nagement or by a decree of a Court of Law and/or that the corner points mentioned in lines 3, 4 and 5 ove were in conformance with the rules of the Michigan Board of Land Surveyors or by a Decree of a urt of Law; established, re-established, monumented, re-monumented, recovered, found as ressed below:

TE: Not more than 4 corners, all in the same town and range, may be recorded on this certificate.

Description of original monument and accessories and/or subsequent restoration:

M-9: Cor. common to Sec. 24 & 25, T27N-R6W, Sec. 19 & 30, T27N-R5W, Bear Lake
1850 GLO re-survey: set post, Hemlck 8", S60W, 16, Hemlck 10", N45W, 34
1936, MDOT, Right-of-way, noted cor., no accessories
3-20-51, MI Depart. of Conserv., Cor. was previously located and perpetuated by Marcus Schaaf from original B.T.'s. Set 1"pipe w/4" brass cap and witnessed 2-12-51
7-11-72, LCRC(N.F. Parker), 9-A, Lib 1 Pg 73
2-93, Wilcox Assoc., top broke off, no witnesses, Lib 1 Pg 73

Description of corner evidence found and/or method applied in restoring or reestablishing corner:

M-9: Cor. common to Sec. 24 & 25, T27N-R6W, Sec. 19 & 30, T27N-R5W, Bear Lake
Fd 1" bent pipe. Pulled & replaced with 5/8" x 36" R.B. w/alu. cap at ground level. No GLO wit. were fd.
On 12-20-94 the Kalkaska Co. peer group approved the above monument as a careful and faithful perpetuation of the position of the original corner.

Ratified by Peer Group
P.A. 345 - 1990 Kalkaska County
Chairman Eugene Farrier
Date 12-20-94

Description of monument for corner and accessories established to perpetuate locating the position of the corner:

M-9: Cor. common to Sec. 24 & 25, T27N-R6W, Sec. 19 & 30. T27N-R5W, Bear Lake
Fd 1" bent pipe. Pulled & replaced with 5/8" x 36" R.B. w/alu. cap at ground level.
S55W, 40.43', fd nail 6" Cherry
S88W, 74.00', fd nail P. Pole
N02E, 34.63', fd nail 24" Maple clump
N22E, 37.57', fd nail 8" Maple clump

STATE OF MICHIGAN
EUGENE D. FARRIER
PROFESSIONAL SURVEYOR
No. 24594
LICENSED PROFESSIONAL SURVEYOR

ned by Eugene Farrier Date 12-22-94

veyor's Michigan License No. 24594

FORM APPROVED BY MICHIGAN STATE BOARD OF LAND SURVEYORS, JAN. 28, 1971
REVISED MAY 14, 1975
REVISED JAN., 1983