

**SURVEY &  
REMONUMENTATION**

**FEB 13 1998**

**SECTION**

**LAND CORNER RECORDATION CERTIFICATE  
Filing Requirement of Act 74, Mich. P.A. 1970**

For corners in

<u>KALKASKA</u> (County)	Located In:	Corner Code #
1997 REMONUMENTATION		
1. Public Land Survey	T <u>27N</u> R <u>7W</u>	<u>A-12</u>
	T _____ R _____	
	<del>T 27N</del> R <u>8W</u>	<u>11-12</u>
	T _____ R _____	
2. Property Controlling in Section	S _____ T _____ R _____	
	S _____ T _____ R _____	
3. Miscellaneous Property in Sec.	S _____ T _____ R _____	
	S _____ T _____ R _____	

Register of Deeds Stamp & File Number

4. Lot No. \_\_\_\_\_, Recorded Plat \_\_\_\_\_

5. Private Claims \_\_\_\_\_

	A	B	C	D	E	F	G	H	I	J	K	L	M
1													
2	6			5			4		3			2	1
3													
4	7			8			9		10			11	12
5													
6	18			17			16		15			14	13
7													
8	19			20			21		22			23	24
9													
10	30			29			28		27			26	25
11													
12	31			32			33		34			35	36
13													

I, EUGENE FARRIER, in a field survey on NOVEMBER 21, 1997 do hereby state that under requirements of P.A. 74, Michigan P.A. of 1970, the corner points mentioned in lines 1 and 2 above were in conformance with regulations and rules therefore as required in the current manual of survey instructions of the United States Department of the Interior, Bureau of Land Management or by a decree of a Court of Law and/or that the corner points mentioned in lines 3, 4 and 5 above were in conformance with the rules of the Michigan Board of Land Surveyors or by a Decree of a Court of Law; established, re-established, monumented, recovered, found as expressed below:


**NOTE: Not more than 2 corners, all in the same town and range, may be recorded on this certificate.**

A. Description of original monument and accessories and/or subsequent restoration:  
A-12: Cor. Common to Sec. 31, T27N-R7W, & Sec. 36, T27N-R8W, Kalkaska Twp.  
 1850 GLO resurvey; set Sugar post, 12" Sugar S16W, 19, 16" Hemlock N70W, 42  
 05-16-1907, Co. Surveyor, used cor., no accessories  
 05-17-1971, J.E. Erickson #16929, LCR, fd. 5/8" pipe #10695, w/accessories  
 12-22-1971, Wilcox & Erickson, Cert. Survey, used cor., no accessories  
 05-19-1972, Donald R. Verea #13603, Cert. Survey, Fd. 5/8" pipe #10695, w/accessories

B. Description of corner evidence found and/or method applied in restoring or reestablishing corner:  
A-12: Cor. Common to Sec. 31, T27N-R7W, & Sec. 36, T27N-R8W, Kalkaska Twp.  
 Fd. 5/8" x 24" iron pipe, pulled and replaced with 5/8" x 18" rebar w/aluminum cap. No GLO witnesses were fd. The Kalkaska Co. Peer group approved & accepted the above monument as the best available evidence of the position of the corner.

Ratified by Peer Group  
 P.A. 345 - 1990 Kalkaska County  
 Chairman Eugene Farrier  
 Date 1-29-98

C. Description of monument for corner and accessories established to perpetuate locating the position of the corner:  
A-12: Cor. Common to Sec. 31, T27N-R7W, & Sec. 36, T27N-R8W, Kalkaska Twp.  
 Fd. 5/8" x 24" iron pipe, pulled and replaced with 5/8" x 18" rebar w/aluminum cap.  
 Set nail & tag N52°W 6" J. Pine 6.39'  
 Set nail & tag S47°E 6" J. Pine 50.58'  
 Set nail & tag S04°E 36" Tw. Maple 44.42'  
 Set nail & tag S35°W 14" Maple 34.34'

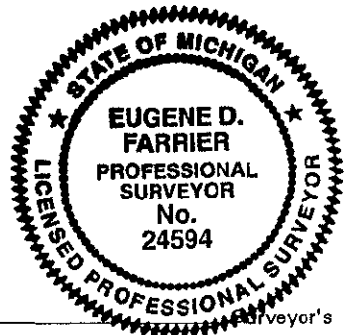

Signed by Eugene Farrier  
 Michigan License No. 24594

Date 2-3-98



**3004889**  
 Page: 1 of 1  
 02/04/98 11:22f