

**SURVEY &
REMONUMENTATION**

FEB 18 1994

COMMISSION LAND CORNER RECORDATION CERTIFICATE
Filing Requirement of Act 74, Mich. P.A. 1970

For corners in

<u>KALKASKA</u> <small>(County)</small>	Located In:	Corner Code #
<u>1993 REMONUMENTATION</u>		
1. Public Land Survey	T <u>27N</u> R <u>7W</u>	<u>E-9</u>
	T _____ R _____	_____
	T _____ R _____	_____
	T _____ R _____	_____
2. Property Controlling in Section	S _____ T _____ R _____	_____
	S _____ T _____ R _____	_____
3. Miscellaneous Property in Sec.	S _____ T _____ R _____	_____
	S _____ T _____ R _____	_____
4. Lot No. _____, Recorded Plat _____		
5. Private Claims _____		

KALKASKA COUNTY, MICHIGAN
RECEIVED

1993 DEC 22 PM 1:30

Jean Hall
REG. OF DEEDS

Register of Deeds Stamp & File Number

EUGENE FARRIER, in a field survey on NOV. 30, 19 93, do hereby certify that under requirements of P.A. 74, Michigan P.A. of 1970, the corner points mentioned in lines 1 and 2 above were in conformance with regulations and rules therefore as required in the current manual of survey instructions of the United States Department of the Interior, Bureau of Land Management or by a decree of a Court of Law and/or that the corner points mentioned in lines 3, 4 and 5 above were in conformance with the rules of the Michigan Board of Land Surveyors or by a Decree of a Court of Law; established, re-established, monumented, re-monumented, recovered, found as expressed below:

A	B	C	D	E	F	G	H	I	J	K	L	M
2	6	5	4	3	2	1						
3												
4	7	8	9	10	11	12						
5												
6	18	17	16	15	14	13						
7												
8	19	20	21	22	23	24						
9												
10	30	29	28	27	26	25						
11												
12	31	32	33	34	35	36						
13												

NOTE: Not more than 4 corners, all in the same town and range, may be recorded on this certificate.

A. Description of original monument and accessories and/or subsequent restoration:


E-9 cor. common to Sec. 20, 21, 28 & 29, T27N-R7W
 1850 GLO re-survey: set post, Hemlock 12" N57E, 47, Maple 12" S50W, 12.
 6-8-1873, D.E. McVee, Co. Surv., County Road Book.
 1907-07 & 25, W.S. Merrill, Co. Surv., Iron Pipe, Cedar 18", S61.5W 89.5
 MSHD, visited cor., plans for M-66, fd 3/4" iron bar, Pg 58 of Sur. BK#1
 10-28-68, L.Beebe, used cor., Hand drawn reference maps file.
 4-1-69, M.A. Koivisto, MSHD, fd boat spk in Mon. Box, set accessories.
 1-5-73, LCRC Liber 1 Pg 164.
 3-7-74, J.L.Fletcher, fd Mon.Box w/3/4" B. spk, Liber 1 Pg 513 of Surv.
 5-28-75, C.J. Hughes, fd Mon.Box w/3/4" B. spk, Liber 1 Pg 657 of Surv.
 5-31-74, J.L.Fletcher, fd Mon.Box w/3/4" B. spk, Liber 1 Pg 550 of Surv.
 12-1-76, J.L.Fletcher, fd Mon.Box w/3/4" B. spk, Liber 2 Pg 1 of Surv.
 12-13-76, J.L.Fletcher, fd Mon.Box w/3/4" B. spk, Liber 1 Pg 951 of Surv.
 8-12-77, J.L.Fletcher, fd Mon.Box w/3/4" B. spk, Liber 2 Pg 52 of Surv.
 8-30-78, J.L.Fletcher, fd Mon.Box w/3/4" B. spk, Liber 2 Pg 247 of Surv.
 11-9-78, LCRC Liber 2 Pg 132.
 6-13-79, J.L.Fletcher, fd Mon.Box w/3/4" B. spk, Liber 2 Pg 351 of Surv.
 1-7-87, J.L. Wilcox, fd Mon.Box w/3/4" B. spk, Liber 3 Pg 95 of Surv.
 7-29-88, N.B. Livasy, fd Mon.Box w/3/4" B. spk, Liber 2 Pg 351 of Surv.

B. Description of corner evidence found and/or method applied in restoring or reestablishing corner:

E-9 cor. common to Sec. 20, 21, 28 & 29, T27N-R7W
 Found 1/2"x18" re-rod in Mon. Box as desc. by Wilcox & Assoc. in Field
 Book 454 pg 26, recovered all 4 witnesses in good condition.
 On 12-16-93 the Kalkaska Co. peer group approved the above monument as a
 careful and faithful reestablishment of the position of the original
 corner.

C. Description of monument for corner and accessories established to perpetuate locating the position of the corner:

E-9 cor. common to Sec. 20, 21, 28 & 29, T27N-R7W
 Found 1/2"x18" re-rod in Mon. Box - Pulled re-rod and replaced w/5/8"x18"
 re-rod w/ Brass Cap.
 N41W, 166.30', S. edge of L shaped steel fnc. post (SW end R/W fnc). fd.
 N35E, 161.87', P. Pole, SE fc (fd nail w/tag).
 S78E, 265.04', 14" Tamark, N fc (fd nail w/tag).
 S35W, 89.03', Guy Pole, Se fc (fd nail w/tag).

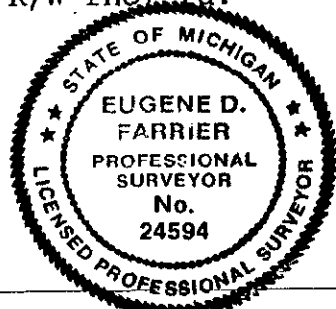

Signed by *Eugene Farrier*
 Surveyor's Michigan License No. 24594

Date 12-22-93