

SURVEY & REMONUMENTATION

FEB 18 1994

COMMISSION

LAND CORNER RECORDATION CERTIFICATE

Filing Requirement of Act 74, Mich. P.A. 1970

KALKASKA COUNTY, MICHIGAN RECEIVED

1993 DEC 22 PM 1:30

Joan Hall REG. OF DEEDS

Register of Deeds Stamp & File Number

For corners in

KALKASKA

(County)

1993 REMONUMENTATION

Located In:

Corner Code -##

- 1. Public Land Survey T 27N R 7W E-11
2. Property Controlling in Section S T R
3. Miscellaneous Property in Sec. S T R

- 4. Lot No. , Recorded Plat
5. Private Claims

I, EUGENE FARRIER, in a field survey on NOV. 23, 19 93, do hereby certify that under requirements of P.A. 74, Michigan P.A. of 1970, the corner points mentioned in lines 1 and 2 above were in conformance with regulations and rules therefore as required in the current manual of survey instructions of the United States Department of the Interior...

NOTE: Not more than 4 corners, all in the same town and range, may be recorded on this certificate.

Grid table with columns A-M and rows 2-13. A dot is marked at the intersection of column D and row 11.

A. Description of original monument and accessories and/or subsequent restoration:


E-11 cor. common to Sec. 28, 29 32 & 33, T27N-R7W 1850 GLO re-survey: set post, Beech 14", S70E, 4; Beech 16", N31W 19. 6-8-1873, D.E. McVee, Co. Surv., County Road Book. MSHD, visited cor., plans for M-66, fd 1 1/4" iron pipe, Pg 58 of Sur. BK#1 1-5-73, LCRC Liber 1 Pg 164. 6-26-75, J.L. Fletcher, fd Mon.Box, Liber 1 Pg 828-829 of Surv. 10-6-75, J.I. Nelson, fd Mon.Box w/3/4" iron, Liber 1 Pg 781-782 of Surv. 12-28-78, LCRC Liber 2 Pg 165. 11-24-80, J.I. Nelson, fd Mon.Box w/3/4" iron, Liber 2 Pg 616-617 of Surv. 7-16-84, E. Farrier, fd Mon.Box w/iron, Liber 2 Pg 840 of Surv. 3-9-87, E. Farrier, fd Mon.Box w/1" B. spk, Liber 3 Pg 101 of Surv.

B. Description of corner evidence found and/or method applied in restoring or reestablishing corner:

E-11 cor. common to Sec. 28, 29 32 & 33, T27N-R7W Found 3/4" Sq. Bolt in Mon. Box in C/L M-66 & Motz road. No evidence of GLO due to road improvement area. On 12-16-93 the Kalkaska Co. peer group approved the above monument as a careful and faithful reestablishment of the position of the original corner.

C. Description of monument for corner and accessories established to perpetuate locating the position of the corner:

E-11 cor. common to Sec. 28, 29 32 & 33, T27N-R7W Found 3/4" Sq Bolt in Mon. Box - Pulled bolt and replaced w/5/8"x18" re-rod w/ Brass Cap. N40E, 68.33', RLS tag in fnc post, fd. N65E, 68.22', RLS tag in fnc post, fd. S58E, 77.17', 8" R. Pine, set. N69W, 116.73', P Pole, fd (no previous record).

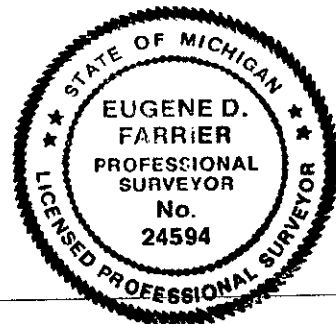

Signed by

[Signature of Eugene D. Farrier]

Date 12-22-93

Surveyor's Michigan License No.

24594