

**SURVEY &  
REMONUMENTATION**

**LAND CORNER RECORDATION CERTIFICATE  
Filing Requirement of Act 74, Mich. P.A. 1970**

KALKASKA COUNTY, MICHIGAN  
RECEIVED  
95 DEC 27 AM 9:53  
*Joan Hall*  
REG. OF DEEDS

For corners in

**JAN 17 1996**

<b>KALKASKA</b> <small>(County)</small>	<b>COMMISSION</b>	Created In:	Corner Code #
<b>1995 REMONUMENTATION</b>			
1. Public Land Survey	T <u>27N</u> R <u>7W</u>		<u>G-12</u>
	T _____ R _____		_____
	T _____ R _____		_____
	T _____ R _____		_____
2. Property Controlling in Section	S _____ T _____ R _____		_____
	S _____ T _____ R _____		_____
3. Miscellaneous Property in Sec.	S _____ T _____ R _____		_____
	S _____ T _____ R _____		_____

Register of Deeds Stamp & File Number

4. Lot No. \_\_\_\_\_, Recorded Plat \_\_\_\_\_  
5. Private Claims \_\_\_\_\_

A	B	C	D	E	F	G	H	I	J	K	L
2	6	5	4	3	2	1					
3											
4	7	8	9	10	11	12					
5											
6	16	17	18	15	14	13					
7											
8	19	20	21	22	23	24					
9											
10	30	29	28	27	26	25					
11											
12	31	32	33	34	35	36					
13											

I, EUGENE FARRIER, in a field survey on Oct. 19, 1995, do hereby certify that under requirements of P.A. 74, Michigan P.A. of 1970, the corner points mentioned in lines 1 and 2 above were in conformance with regulations and rules therefore as required in the current manual of survey instructions of the United States Department of the Interior, Bureau of Land Management or by a decree of a Court of Law and/or that the corner points mentioned in lines 3, 4 and 5 above were in conformance with the rules of the Michigan Board of Land Surveyors or by a Decree of a Court of Law; established, re-established, monumented, re-monumented, recovered, found as expressed below:

**NOTE: Not more than 4 corners, all in the same town and range, may be recorded on this certificate.**

**A. Description of original monument and accessories and/or subsequent restoration:**

G-12: Cor. common to Sec. 33 & 34, T27N-R7W, Kalkaska  
1850 GLO re-survey: set 1/4 sec. post, Sgr 14", S70W, 7; Bech 4", N70E, 39.  
1901, W.S. Merrill, Co. Surv, stone, no accessories.  
8-2-1990, E.D. Farrier, CERT OF SURVEY, fd 1/2" rerod, tied crnr.  
9-7-1990, LCRC(E.D. Farrier), G-12, fd. 1/2" rerod, L.2 PG.424.

**B. Description of corner evidence found and/or method applied in restoring or reestablishing corner:**

G-12: Cor. common to Sec. 33 & 34, T27N-R7W, Kalkaska  
Fd 1/2" x 18" R.B., 3' West of c/l of Mitchell Rd. (2-track) & on fence to West. Pulled & replaced with 5/8" x 18" R.B. w/brass cap 0.5' below grade. No GLO wit. were fd. The Kalkaska Co. peer group approved the above monument and is accepted as the best available evidence of the position of the original corner.


Ratified by Peer Group  
P.A. 345 - 1990 Kalkaska County  
Chairman Eugene Farrier  
Date 12-22-95

**C. Description of monument for corner and accessories established to perpetuate locating the position of the corner:**

G-12: Cor. common to Sec. 33 & 34, T27N-R7W, Kalkaska  
Fd 1/2" x 18" R.B. Pulled & replace with 5/8" x 18" R.B. w/brass cap 0.5' below grade.  
Set nail & tag N80W, cor of fence post, 21.42'  
Set nail & tag N15W, 13" Maple, 40.02'  
Set nail & tag N65E, 10" Maple, 36.48'  
Set nail & tag S53E, 14" R. Pine, 50.18'

Signed by Eugene Farrier  
Surveyor's Michigan License No. 24594

Date 12-22-95

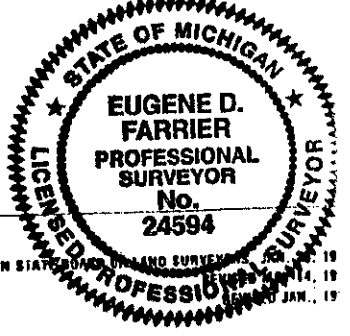

FORM APPROVED BY MICHIGAN STATE BOARD OF LAND SURVEYORS  
JAN. 19