

SURVEY &
REMONUMENTATION

JAN 17 1996 LAND CORNER RECORDATION CERTIFICATE
Filing Requirement of Act 74, Mich. P.A. 1970

KALKASKA COUNTY, MICHIGAN
RECEIVED

95 DEC 27 AM 9:53

For corners in

COMMISSION

Jean Hall
REG. DEPT.

KALKASKA <small>(County)</small>		Located In:	Corner Code #
1995 REMONUMENTATION			
1. Public Land Survey	T <u>27N</u> R <u>7W</u>		<u>H-13</u>
	T _____ R _____		_____
	T _____ R _____		_____
	T _____ R _____		_____
2. Property Controlling in Section	S _____ T _____ R _____		_____
	S _____ T _____ R _____		_____
3. Miscellaneous Property in Sec.	S _____ T _____ R _____		_____
	S _____ T _____ R _____		_____
4. Lot No. _____, Recorded Plat _____			
5. Private Claims _____			

Register of Deeds Stamp & File Number

I, EUGENE FARRIER, in a field survey on Oct. 18, 19 95, do hereby certify that under requirements of P.A. 74, Michigan P.A. of 1970, the corner points mentioned in lines 1 and 2 above were in conformance with regulations and rules therefore as required in the current manual of survey instructions of the United States Department of the Interior, Bureau of Land Management or by a decree of a Court of Law and/or that the corner points mentioned in lines 3, 4 and 5 above were in conformance with the rules of the Michigan Board of Land Surveyors or by a Decree of a Court of Law; established, re-established, monumented, re-monumented, recovered, found as expressed below:

A	B	C	D	E	F	G	H	I	J	K	L
2	8	5	4	3	2	1					
3											
4	7	6	9	10	11	12					
5											
6	18	17	16	15	14	13					
7											
8	19	20	21	22	23	24					
9											
10	30	29	28	27	26	25					
11											
12	31	32	33	34	35	36					
13											

NOTE: Not more than 4 corners, all in the same town and range, may be recorded on this certificate.

A. Description of original monument and accessories and/or subsequent restoration:

H-13: S 1/4 Cor of Sec. 34, T27N-R7W, Kalkaska
1850 GLO re-survey: set 1/4 sec.post, Bech 8", S57W, 10; Bech 5", N35E 33.
8-2-1990, E.D.Farrier, CERT OF SURV, fd. old 1/2" iron over wagon skien.
9-7-1990, LCRC(E.D.Farrier), H-13, fd. old 1/2" rod/wgn skien, L.2 PG.424.


B. Description of corner evidence found and/or method applied in restoring or reestablishing corner:

H-13: S 1/4 Cor of Sec. 34, T27N-R7W, Kalkaska
Fd 1/2" iron w/cap #24594. Pulled and replaced with 5/8" x 18" R.B. w/brass cap 0.3' below Rd. Surface. Fd corner also falls in c/l of Anderson Rd. and on fence to north & 93' East of fence to south. No GLO witnesses were found. The Kalkaska Co. peer group approved the above monument and is accepted as the best available evidence of the position of the original corner.

Ratified by Peer Group
P.A. 345 - 1990 Kalkaska County
Chairman *Eugene Farrier*
Date 12-19-95

C. Description of monument for corner and accessories established to perpetuate locating the position of the corner:

H-13: S 1/4 Cor of Sec. 34, T27N-R7W, Kalkaska
Fd 1/2" iron w/cap #24594. Pulled and replaced with 5/8" x 18" R.B. w/brass cap 0.3' below Rd. Surface.
Set nail & tag, N05E, 8" Elm, 37.72'
Set nail & tag, S50W, 9" R. Pine, 74.75'
Set nail & tag, S15W, 10" R. Pine, 51.32'
Set nail & tag, S35E, 8" R. Pine, 67.10'
West, N 1/4 Cor., Sec 3, T26N-R7W, Kal.Co.Mon, 99.05'

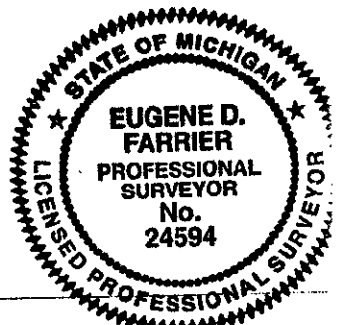

Signed by *Eugene Farrier* Date 12-22-95
Surveyor's Michigan License No. 24594